

CENTRAL MAPPING AUTHORITY

GEODETIC SURVEY OF R.S.W.
 GEODETIC STATION RECONNAISSANCE and MAINTENANCE REPORT

Description:

1. Cleared by lanes bearing.....**NOT CLEARED SINCE WW II**..... from Trig. Mast
 Note: Cross out word or words which do not apply
2. Mast & Vanes have been painted white & black respectively.
3. The station ~~was~~ **was** ~~unpiled/~~ ~~not unpiled/~~ ~~concrete~~ on.....**CONC**.....**19**....., dimensions now being:
 Description of mark.....**CONC**.....~~should be explicit, e.g., Street Pillar-Plate, Steel Plug, Brass Plug, Bolt, G.I. Pipe~~

Height of mark.....**NA**.....m. ^{above} ~~below~~ rock/concrete; Mark is.....m. ^{above} ~~below~~ G.L.

Height of Top Vanes to Top Mark/Pillar plate**NA**.....m. Diameter of Vanes (vertical).....m.

Height of Cairn.....**NA**.....m. Diameter of Cairn.....m. Name Plate found/not found/placed.

Length of Mast.....**NA**.....m. (approximate if not unpiled)

4. A.....**NA**.....set in conc/rock has been placed/found, bearing.....°M from Mast/Plug/Pillar

5. A.....**NA**.....set in conc/rock has been placed/found, bearing.....°M from Mast/Plug/Pillar

6. A.....**NA**.....set in conc/rock has been placed/found, bearing.....°M from Mast/Plug/Pillar

7. A.....**NA**.....set in conc/rock has been placed/found, bearing.....°M from Mast/Plug/Pillar

8. Action required.....**GOOD STATION. 1 DAYS CLEARING. Not Suitable for Pillar.**

STANDPOINT:

Mark	Direction	HORIZ. Distance	Height Difference	Mark	Direction	HORIZ. Distance	Height Difference
			above standpt				above standpt
			below				below
			above standpt				above standpt
			below				below
Prepared by: *[Signature]*

Checked:

Noted on U.T.M. Card

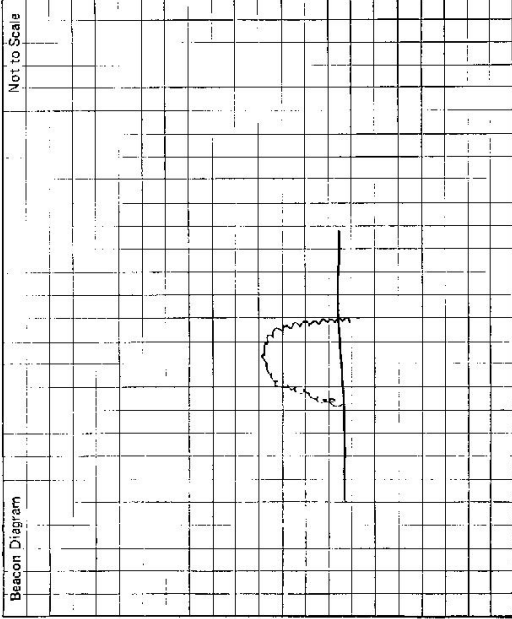
ST 2733-1

STATION: **Murrumbuckets** No.: **3290**
 MAP SHEET SCALE 1:250 000 **3EGA 5J/55-4**
 INSPECTED BY: **J. SHERWIN** DATE: **30/6/18**
 AUTHORITY: **(ATS) CMA** FIELD BOOK: **---**

Station Diagram
 North
 Not to Scale

[Signature] / Checked

SI 2725-2 D. West, Government Printer

<p>STATION Murrumbucka T.S. 3290</p>	<p>Owner's Name: Don McDonald Address: "Oakvale" Phone:</p>	<p>Current Occupant:</p>	<p>Address:</p>	<p>Phone:</p>	<p>Access Report of: 1896 ^{not} found ACCESS 30-6-1980 was found at</p>
<p>26 km North of Ceana on the Manaro Highway turn west on the road marked "Riverview" 7 km towards "Murrumbucca" enter gate marked Oakvale SEE OWNER.</p>		<p>From "Oakvale" Drive SW along fire trail 1.8 km Turn north and drive 3 km to locked gate. Proceed north along fence 700 m to ridge Drive SE down ridge to saddle Walk from saddle ESE to Murrumbucka TS On hill locally known as the Pinnacle.</p>			
<p>Beacon Diagram</p>  <p style="text-align: right;">Not to Scale</p>		<p>This section to be completed by officer constructing pillar. Original station mark found/not found. Description of mark: Trig Cairn Original beacon found/not found. Description of beacon: Height Top of Vanes to Top Markm. Height of markm. ^{above} below rock/concm. ^{above} below G.L. Diameter of Vanesm. Height of Cairnm. Original Beacon has/has not been destroyed by me.</p>			
		Date		Record of Station	