

CENTRAL MAPPING AUTHORITY  
Department of Lands

Trigonometrical Survey of N.S.W.

RECONNAISSANCE and MAINTENANCE REPORT

This Trig. Station has been:-

Note: Cross out word or words which do not apply

1. Completely cleared to permit 360° vision to surrounding Trigs.
2. Cleared by lanes bearing  $25^{\circ} 57' 45.52''$  to  $130^{\circ} 4' 19.19''$  to  $250^{\circ} 28' 0''$  to  $340^{\circ}$  from Trig. Mast  
(~~lanes marked 250° to 340°~~) (~~lanes marked 250° to 340°~~)
3. Trig. Mast & Vanes have been painted white & black respectively.
4. The Trig. was ~~revised~~ not unpiled, dimensions now being:

Description of mark..... should be explicit, e.g. Steel plug, Brass plug, Bolt, G.I. Pipe  
 Height of mark..... m <sup>above</sup> rock/concrete ..... m <sup>below</sup> G.L.  
 Height of Top Vanes to Top Mark..... m. Diameter of Vanes (vertical)..... m.  
 Height of Cairn..... m. Diameter of Cairn..... m.  $1.90$   
 Length of Mast..... m. (approximate if not unpiled)

5. A..... set in conc/rock has been placed..... m. bearing..... °M from Trig. Mast
6. A..... set in conc/soil has been placed..... m. bearing..... °M from Trig. Mast
7. A..... set in conc/soil has been placed..... m. bearing..... °M from Trig. Mast
8. A..... set in conc/rock has been placed..... m. bearing..... °M from Trig. Mast
9. Connection..... to..... m. bearing..... °M
10. Connection..... to..... m. bearing..... °M
11. Connection..... to..... m. bearing..... °M
12. Connection..... to..... m. bearing..... °M
13. Diff. Ht. .... is..... m. <sup>above</sup> below
14. Diff. Ht. .... is..... m. <sup>above</sup> below
15. Diff. Ht. .... is..... m. <sup>above</sup> below
16. Diff. Ht. .... is..... m. <sup>above</sup> below

Prepared by: *[Signature]* Checked: *[Signature]*

Moved on U.T.M. Card

STATION *MURU* TS *3292*


Co: *ANNIES* Pht: *URAMARUKI*

Map Sheet: *YARROWIZEN* No: *92.35*

Inspected by: *M.L. Macgregor* Date: *13/7/77*

Authority: *Not to Scale* Field Book: *1580*

Beacon Diagram

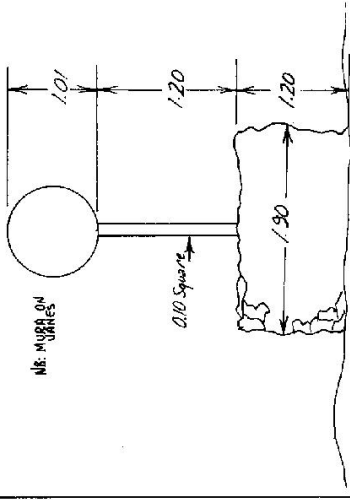

Date

Record of Station

*SSM in Car Rd. Hill is a Low Hill Surrounded by High Ridges. No Clearings Required*

Checked

