


TS 3295

STATION: MERWIN No.: E409

MAP SHEET SCALE 1:250 000 INSPECTED BY: J. SHERWIN DATE: 18/10/78

AUTHORITY: FIELD BOOK:

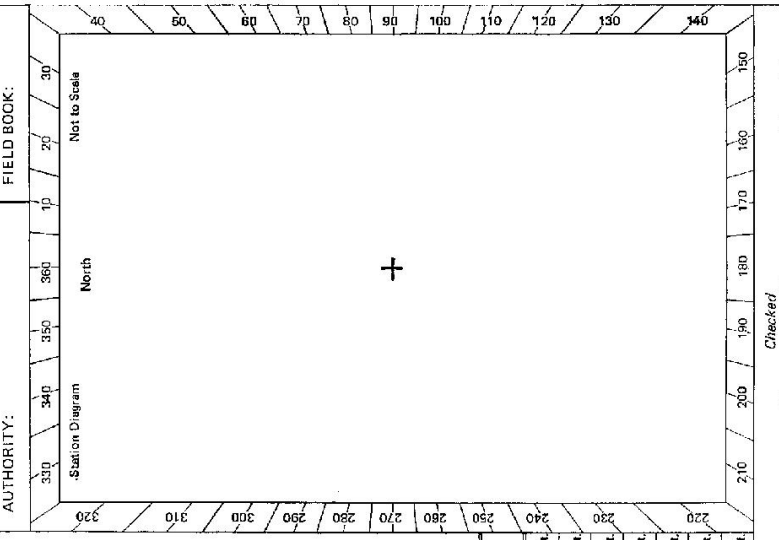

CENTRAL MAPPING AUTHORITY
 GEODETIC SURVEY OF NSW
 GEODETIC STATION RECONNAISSANCE and MAINTENANCE REPORT

- Description:
 Note: Cross out word or words which do not apply
- 1- Cleared by lanes bearing..... from Trig. Mast
 - 2- Mast & Vanes have been painted white & black respectively.
 3. The station/pillar was unpiled/not unpiled/constructed on..... 18/10 19 78, dimensions now being:
 Description of mark. ~~Round~~ ~~rod~~ ~~rod~~ should be explicit, e.g., ~~Steel~~ ~~Pillar~~ ~~Plate~~ ~~Steel~~ ~~plug~~ ~~Brass~~ ~~plug~~ ~~Bolt~~ ~~Grt.~~ ~~Pipe~~
 Height of mark. ~~Round~~ ~~m.~~ ~~above~~ ~~rock~~ ~~concrete~~; Mark ism. above G.L.
 Height of Top Vanes to Top Mark/Pillar platem. Diameter of Vanes (vertical).....m.
 Height of Cairn.....m. Diameter of Cairn.....m. Name Plate found/not found/placed.
 Length of Mast.....m. (approximate if not unpiled)
 - 4- A.....set in conc/rock has been placed/found, bearing.....° M from Mast/Plug/Pillar
 - 5- A.....set in conc/rock has been placed/found, bearing.....° M from Mast/Plug/Pillar
 - 6- A.....set in conc/rock has been placed/found, bearing.....° M from Mast/Plug/Pillar
 - 7- A.....set in conc/rock has been placed/found, bearing.....° M from Mast/Plug/Pillar
 - 8- Action required:.....

STANDPOINT:

Mark	Direction	Horiz. Distance	Height Difference	Mark	Direction	Horiz. Distance	Height Difference
			above standpt.				above standpt.
			below				below
			above standpt.				above standpt.
			below				below
Prepared by: *J. Sherwin* 18/11/78
 Checked: *J. Sherwin* 16/11/78
 Noted on U.T.M. Card

CENTRAL MAPPING AUTHORITY

GEODETIC SURVEY OF N.S.W.

GEODETIC STATION RECONNAISSANCE and MAINTENANCE REPORT

STATION: **MERWIN** No.: **3295**

MAP SHEET SCALE 1:250 000

INSPECTED BY: **C. BOSLOPER**


AUTHORITY: **C.M.A.**

DATE: **21-7-82**

FIELD BOOK: **2192**

Description: *Read will.* Note: *Cross out word or words which do not apply*

1. Cleared by lanes bearing.....
2. Mast & Vanes have been painted white & black respectively.
3. The station/pillar was unpiled/not unpiled/constructed on..... 19....., dimensions now being:
Description of mark.....should be explicit, e.g., S/Steel Pillar Plate, Steel plug, Brass plug, Bolt, G.I. Pipe
Height of mark.....m. ^{above} rock/concrete; Mark is.....m. ^{above} G.L.
Height of Top Vanes to Top Mark/Pillar plate.....m. Diameter of Vanes (vertical).....m.
Height of Cairn.....m. Diameter of Cairn.....m. Name Plate found/not found/placed.
Length of Mast.....m. (approximate if not unpiled)
4. A.....set in conc/rock has been placed/found, bearing.....°M from Mast/Plug/Pillar
5. A.....set in conc/rock has been placed/found, bearing.....°M from Mast/Plug/Pillar
6. A.....set in conc/rock has been placed/found, bearing.....°M from Mast/Plug/Pillar
7. A.....set in conc/rock has been placed/found, bearing.....°M from Mast/Plug/Pillar
8. Action required: *Repair of vanes*

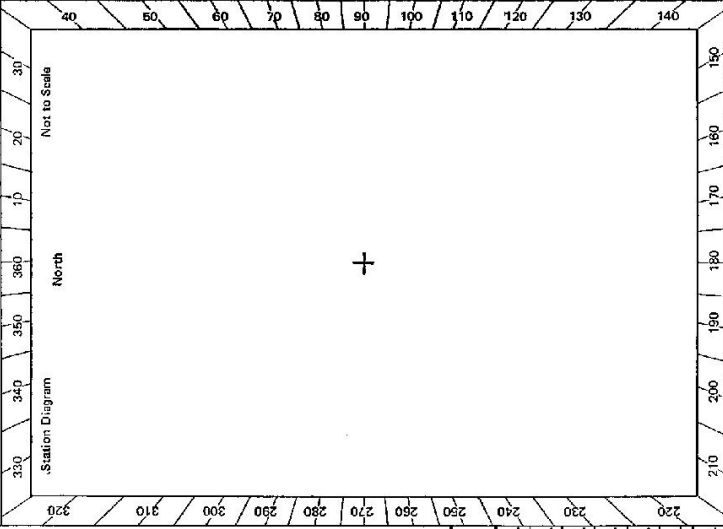

STANDPOINT:

Mark	Direction	Horiz. Distance	Height Difference	Mark	Direction	Horiz. Distance	Height Difference
			above standpt.				below standpt.
			below standpt.				above standpt.
			above standpt.				below standpt.
			below standpt.				above standpt.
Prepared by: *CA*

Checked: *CA*

Noted on U.T.M. Card

<p>Owner's Name: Merwin Pastoral Company Address:</p> <p>Phone:</p> <p>Current Occupant: John Douglas Address: M. E. ...</p> <p>Phone: 050 340528 Mullan exchange</p> <p>ACCESS Access Report of 21/1/1982 was found suitable/unsuitable.</p> <p>3.5 R.O. Balmuldah, head eastwards Turn right on Stuart Hwy. 15.2 Moulmein intersection, turn left. 25.2 Pass Kygite intersection on right. 33.8 Take track veering off on left. 34.5 Go through double gate, turn slightly to the left. 35.1 double gate. 38.2 go over drain. 39.6 double gate. 43.7 leave track and make even way to the bog on the left. 44.4 Quadrupad; can be driven to by 2WS vehicle.</p>	<p style="text-align: center;">STATION MERWIN TS 3295</p> <p>Owner's Name: Merwin Pastoral Company Address:</p> <p>Phone:</p> <p>Current Occupant: John Douglas Address: M. E. ...</p> <p>Phone: 050 340528 Mullan exchange</p> <p>ACCESS Access Report of 21/1/1982 was found suitable/unsuitable.</p> <p>3.5 R.O. Balmuldah, head eastwards Turn right on Stuart Hwy. 15.2 Moulmein intersection, turn left. 25.2 Pass Kygite intersection on right. 33.8 Take track veering off on left. 34.5 Go through double gate, turn slightly to the left. 35.1 double gate. 38.2 go over drain. 39.6 double gate. 43.7 leave track and make even way to the bog on the left. 44.4 Quadrupad; can be driven to by 2WS vehicle.</p>
<p>Beacon Diagram</p> <p><i>Beacon is a quadrupad with 0.9m vanes Vanes have been destroyed by wind action, quadrupad is still in good order.</i></p> <p><i>Vanes are to be replaced</i></p> <p><i>Vanes scrapped out set back 1 meter 1.5m</i></p> <p>Not to Scale</p>	<p>This section to be completed by officer constructing pillar.</p> <p>Original station mark found/not found.</p> <p>Description of mark:</p> <p>Original beacon found/not found.</p> <p>Description of beacon:</p> <p>Height Top of Vanes to Top Markm.</p> <p>Height of markm. above G.L. below rock/conc.m. below</p> <p>Diameter of Vanesm. Height of Cairnm.</p> <p>Original Beacon has/not been destroyed by me.</p>