

GEODETIC SURVEY OF NSIK

CENTRAL MAPPING AUTHORITY

GEODETIC STATION RECONNAISSANCE and MAINTENANCE REPORT

Description:

1. Cleared by lanes bearing..... Note: Cross out word or words which do not apply
2. Mast & Vanes have been painted white & black respectively.
3. The station/pillar was unpiled/not unpiled/constructed on..... 19....., dimensions now being: **base, plug and**..... should be explicit, e.g, S/Steel Pillar Plate, Steel plug, Brass plug, Bolt, G.I. Pipe

Description of mark..... from Trig. Mast

Height of mark.....m. above below rock/concrete; Mark is.....m. above below G.L.

Height of Top Vanes to Top Mark/Pillar plate.....m. Diameter of Vanes (vertical).....m.

Height of Cairn.....m. Diameter of Cairn.....m. Name Plate found/not found/placed.

Length of Mast.....m. (approximate if not unpiled)

4. A.....set in conc/rock has been placed/found, bearing.....°M from Mast/Plug/Pillar

5. A.....set in conc/rock has been placed/found, bearing.....°M from Mast/Plug/Pillar

6. A.....set in conc/rock has been placed/found, bearing.....°M from Mast/Plug/Pillar

7. A.....set in conc/rock has been placed/found, bearing.....°M from Mast/Plug/Pillar

8. Action required: **AVENUE A. SEWATERY. N.O. CAIRN. WEDED. TO. MAST. STRE. S.A.T.S.**

STANDPOINT:

Mark	Direction	Horiz. Distance	Height Difference	Mark	Direction	Horiz. Distance	Height Difference
			above standpt.				above standpt.
			below standpt.				below standpt.
			above standpt.				above standpt.
			below standpt.				below standpt.
Prepared by: *Rodney Cook*

Checked: *Rodney Cook*

Notes on U.I.M. Card

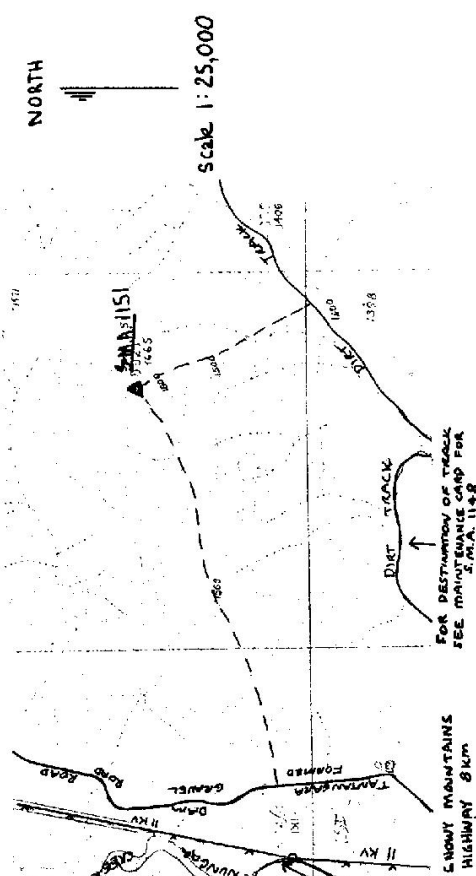
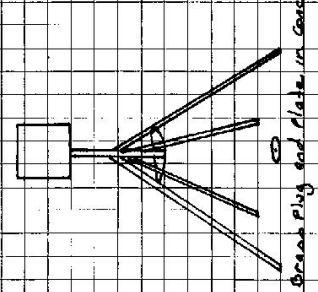
St 2733-1

STATION: **S.M.A. 1151** TS No.: **33**

MAP SHEET SCALE 1:250 000 **TANTANGARA 1: 100,000**

INSPECTED BY: **R. COOK** DATE: **7-3-79**

AUTHORITY: **C.M.A.** FIELD BOOK:

S. 2733-2 D. West, Government Printer Beacon Diagram Not to Scale	Owner's Name: Address: <i>situated within the</i> <i>KASSELUKOP NATURAL PARK</i> Phone: ACCESS Access Report of <i>Z.1.3/1977</i> was found suitable/unsuitable.	STATION S.M.A. 1151 TS 33 Current Occupant: Address: Phone:  Scale 1:25,000 NORTH S.M.A. 1151 ROAD DIRT TRACK FOR DESTRUCTION OF TRACK FEE MAINTENANCE CAP FOR S.M.A. 1148 SNOWY MOUNTAINS HIGHWAY 8 km Date: <i>7-3-79</i> Record of Station: <i>Reason for absence of Trig during field completion of Tumbungara 1:25,000 Access taken off the Tumbungara 1:25,000 Provisional</i>
Beacon Diagram Not to Scale	 <p><i>Wooden quadrangle with square corrugated Vanes</i></p> <p><i>Break plug and plate in case</i></p> <p>WOODEN QUADRANGLE with square corrugated Vanes</p> <p>MUMBAR CREEK FIRE TOWER</p>	This section to be completed by officer constructing pillar. Original station mark found/not found. Description of mark: Original beacon found/not found. Description of beacon: Height: Top of Vanes to Top Markm. Height of mark:m. above rock/centrem. above G.L. Diameter of Vanesm. Height of Cairnm. Original Beacon has/has not been destroyed by me.