

CENTRAL MAPPING AUTHORITY

GEODETIC SURVEY OF M.S.W.

GEODETIC STATION RECONNAISSANCE and MAINTENANCE REPORT

Description:

Note: Cross out word or words which do not apply

1. Cleared by lances bearing $172^{\circ}30'00''$ $192^{\circ}30'00''$ $212^{\circ}30'00''$ from Trig. Mast
2. Mast & Vanes have been painted white & black respectively. ✓
3. The station/~~pillar~~ was unplied/~~not unplied~~/~~constructed~~ on ~~concrete~~ $102^{\circ}30'00''$ $122^{\circ}30'00''$ $142^{\circ}30'00''$, dimensions now being: Description of mark ~~concrete~~ should be explicit, e.g., S/Steel Pillar Plate, Steel plug, Brass plug, Bolt, G.I. Pipe
Height of mark 0.275 m. above ~~below~~ ~~below~~ Mark is 0.275 m. above ~~below~~ G.L.
Height of Top Vanes to Top Mark/~~pillar plate~~ 2.25 m. Diameter of Vanes (vertical) 76.2 mm.
Height of Cairn 0.26 m. Diameter of Cairn 76 mm. Name Plate ~~found/not-found~~/placed.
Length of Mast 3.445 m. (approximate if not unplied)
4. A ~~Conc. Mast~~ set in conc/~~rock~~ has been placed/~~found~~, bearing 96° M from ~~Mast/Plug/Pillar~~
5. A ~~Conc. Mast~~ set in conc/~~rock~~ has been placed/~~found~~, bearing 14° M from ~~Mast/Plug/Pillar~~
6. A ~~Conc. Mast~~ set in conc/~~rock~~ has been placed/~~found~~, bearing 106° M from ~~Mast/Plug/Pillar~~
7. A ~~Conc. Mast~~ set in conc/~~rock~~ has been placed/~~found~~, bearing 106° M from ~~Mast/Plug/Pillar~~
8. Action required:

STANDPOINT:


Mark	Direction	Horiz. Distance	Height Difference	Mark	Direction	Horiz. Distance	Height Difference
Mast/Plug/Pillar	0 000 00		above standpt.	Mast/Plug/Pillar	0 000 00		above standpt.
Conc. Mast	31 14 30		above standpt.	Conc. Mast	31 14 30		above standpt.
Cairn	24 55 30	0.090	below standpt.	Cairn	24 55 30	0.090	below standpt.
Conc. Mast	34 38 50	4.242	above standpt.	Conc. Mast	34 38 50	4.242	above standpt.
Conc. Mast	38 50	4.361	above standpt.	Conc. Mast	38 50	4.361	above standpt.
			below standpt.				below standpt.
			above standpt.				above standpt.
			below standpt.				below standpt.
			above standpt.				above standpt.
			below standpt.				below standpt.

Prepared by:

Checked:

Notes on U.T.M. Card

SI 2738 - 1

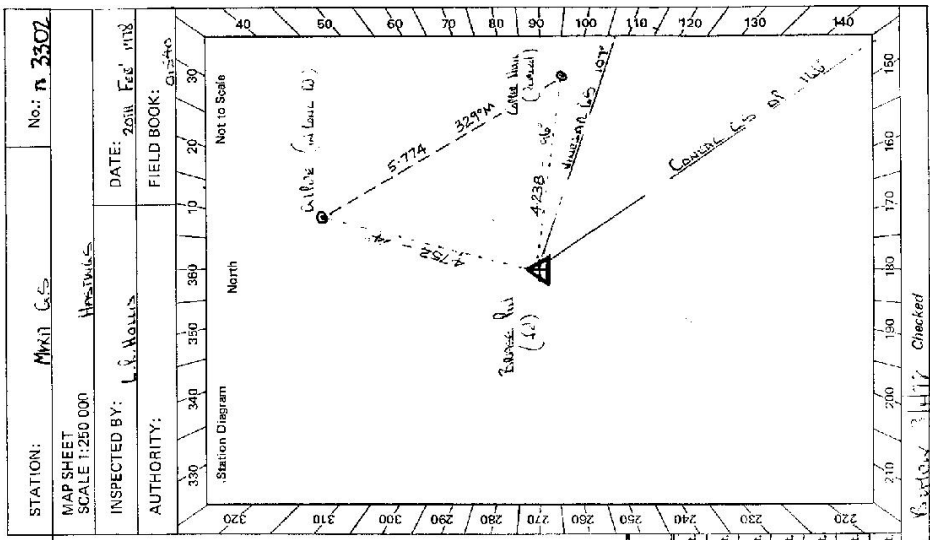

STATION: Mast/Plug/Pillar No: n 3302
 MAP SHEET SCALE 1:250 000
 INSPECTED BY: L.S. HOLLIS DATE: 25th Feb 1978
 AUTHORITY: FIELD BOOK: G.S. 440

