

CENTRAL MAPPING AUTHORITY

GEODETIC SURVEY OF N.S.W.

GEODETIC STATION RECONNAISSANCE and MAINTENANCE REPORT

Description:

Notes: Cross out word or words which do not apply

- Cleared by lanes bearing $20-75 / 115-159 / 178-193$ from Trig. Mast
 No Mast & Vanes have been painted white & black respectively
- The station/pillar was unpainted/~~rest-applied/constructed on~~ 19..... dimensions now being:
 Description of mark: $5/5$ in. ^{above} rock/concrete; ^{below} m. above G.L.
 Height of mark:m. ^{above} rock/concrete; ^{below} m. above G.L.
 Height of Top Vanes to Top Mark/~~complete~~ 1.335.....m. Diameter of Vanes (vertical) No. vanes: 4
 Height of Cairn:m. Diameter of Cairn:m. Name Plate found/not found/~~placed~~.
 Length of Mast:m. (approximate if not upright)
- A..... set in conc/rock has been placed/found, bearing.....°M from Mast/Plug/Pillar
- A..... set in conc/rock has been placed/found, bearing.....°M from Mast/Plug/Pillar
- A..... set in conc/rock has been placed/found, bearing.....°M from Mast/Plug/Pillar
- A..... set in conc/rock has been placed/found, bearing.....°M from Mast/Plug/Pillar
- Action required:.....

KANGAROO VALLEY
 Steel Topo

STANDPOINT:		STANDPOINT:		STANDPOINT:		STANDPOINT:	
Mark	Direction	Horiz. Distance	Height Difference	Mark	Direction	Horiz. Distance	Height Difference
			above standpt. below				above standpt. below
			above standpt. below				above standpt. below
Prepared by: *[Signature]* 24/1
 Checked: *[Signature]*

S: 2733-1

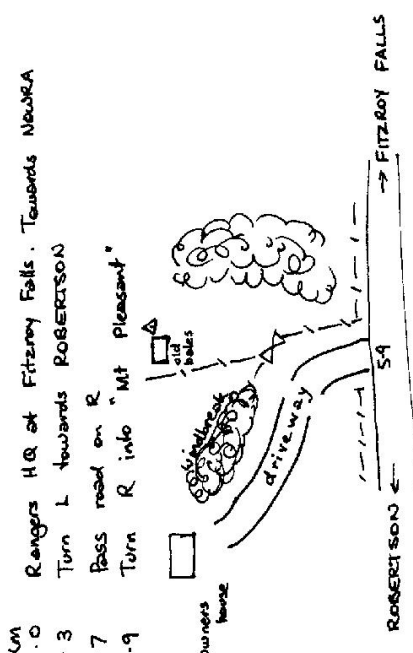
STATION: MYRA VALE	No.: 3304
MAP SHEET SCALE 1:250 000	Wollongong
INSPECTED BY: A. Sivertsen	DATE: 16-1-79
AUTHORITY: CMA	FIELD BOOK: 1723

Station Diagram

North

Not to Scale

Checked

Br 2733-2.D. West, Government Printer Beacon Diagram	STATION MVRA VALE TS 3304	Owner's Name: Address: Phone: Current Occupant: Address: Phone:	Access Report of <u>16.1.18M</u> was found suitable/unavailable. ACCESS km 0.0 Rangers HQ at Fitzroy Falls. Towards NAWURA 1-3 Turn L towards ROBERTSON 1-7 Pass road on R 5-9 Turn R into "Mt Pleasant" owners house 
Not to Scale			
This section to be completed by officer constructing pillar. Original station mark found/not found.			
Description of mark: Original beacon found/not found.			
Description of beacon: Height Top of Vanes to Top Markm. Height of markm. above G.L. / below G.L. Diameter of Vanesm. Height of Cairnm. Original Beacon has/has not been destroyed by me.			
Date		Receipt of Station	