

CENTRAL MAPPING AUTHORITY

GEODETIC SURVEY OF NSW

GEODETIC STATION RECONNAISSANCE and MAINTENANCE REPORT

Description:

1. Cleared by lanes bearing *Timbered all around* *Note: Cross out word or words which do not apply*

2. Mast & Vanes have been painted white & black respectively. in Corn of rocks found.

3. The station/pillar was unpiled/not unpiled/constructed on.....19....., dimensions now being:

Description of mark.....should be explicit, e.g., S/Steel Pillar Plate, Steel plug, Brass plug, Bolt, G.I. Pipe

Height of mark.....m. ^{above} _{below} rock/concrete; Mark is.....m. ^{above} _{below} G.I.

Height of Top Vanes to Top Mark/Pillar plate.....m. Diameter of Vanes (vertical).....m.

Height of Cairn.....m. Diameter of Cairn.....m. Name Plate found/not found/placed.

Length of Mast.....m. (approximate if not unpiled)

4. A.....set in conc/rock has been placed/found, bearing.....°M from Mast/Plug/Pillar

5. A.....set in conc/rock has been placed/found, bearing.....°M from Mast/Plug/Pillar

6. A.....set in conc/rock has been placed/found, bearing.....°M from Mast/Plug/Pillar

7. A.....set in conc/rock has been placed/found, bearing.....°M from Mast/Plug/Pillar

8. Action required: *3 days clearing. Station suitable for pillar construction*

STANDPOINT:

STANDPOINT:

Mark	Direction	Horiz. Distance	Height Difference	Mark	Direction	Horiz. Distance	Height Difference
			above standpt.				above standpt.
			below standpt.				below standpt.
			above standpt.				above standpt.
			below standpt.				below standpt.
Prepared by: *D.K. Amodeo* 27/6/79

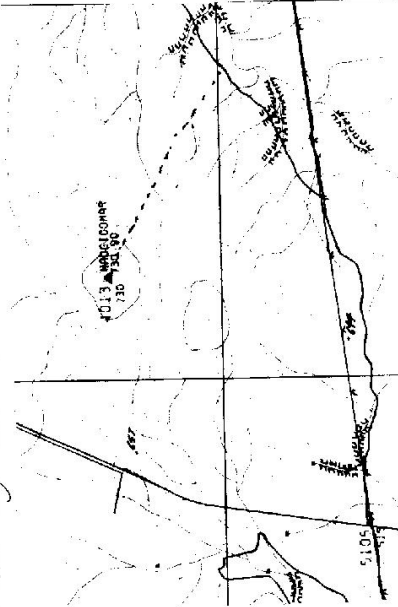
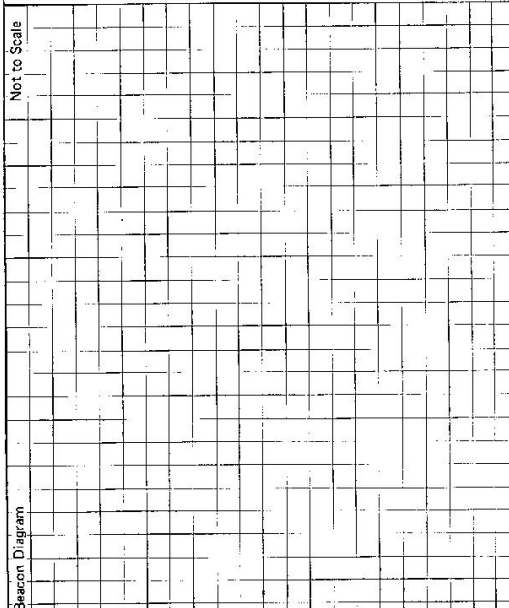
Noted on U.T.M. Card

Checked

S:2733-1

STATION: <i>Appercombe</i>		No.: <i>3309</i>	
MAP SHEET SCALE 1:250 000		<i>CANBERRA</i>	
INSPECTED BY: <i>D.K. Amodeo</i>		DATE: <i>MAY 79</i>	
AUTHORITY: <i>C.M.A.</i>		FIELD BOOK:	

G

STATION <i>NAOSKOMAR</i> TS <i>3309</i>	
<p>Owner's Name: Address: Phone:</p> <p>Current Occupant: Address: Phone:</p> <p style="text-align: center;">May 1974</p> <p>Access Report of/19..... was found suitable/unsuitable.</p> <p style="text-align: center;">ACCESS</p> <p><i>A 4 wheel drive vehicle can be negotiated through timber, along the route shown on the sketch below, to the trig station.</i></p>	
<p>Beacon Diagram</p> <p>Not to Scale</p> 	<p>This section to be completed by officer constructing pillar.</p> <p>Original station mark found/not found.</p> <p>Description of mark:</p> <p>Original beacon found/not found.</p> <p>Description of beacon:</p> <p>Height Top of Vanes to Top Markm.</p> <p>Height of markm. above rock/contcm. above G.L. below</p> <p>Diameter of Vanesm. Height of Calmm.</p> <p>Original Beacon has/has not been destroyed by me.</p>
<p>Date</p> <p>Record of Station</p>	