


CENTRAL MAPPING AUTHORITY
 GEODETIC SURVEY OF A.S.W.
 STATION: **MANO CS** No.: **3316**

MAP SHEET
 SCALE 1:250 000
 INSPECTED BY: **L. HITCHINS** DATE: **3 7 81**

AUTHORITY: **C.M.A.** FIELD BOOK: **1810**

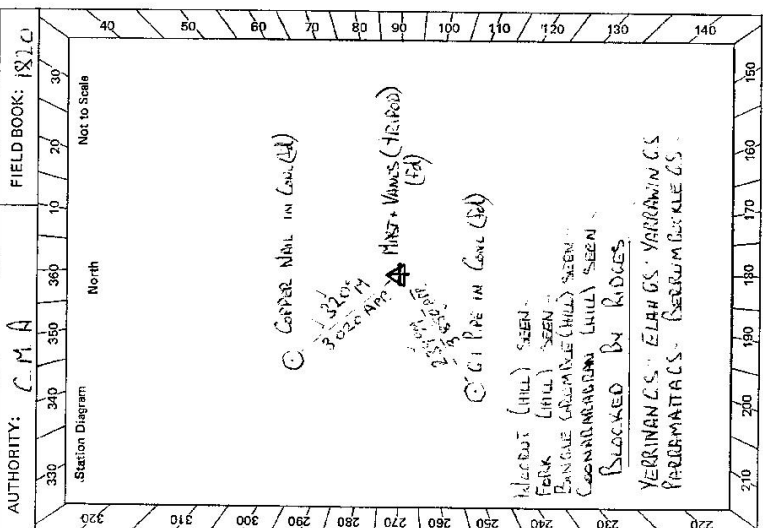

GEODETIC STATION RECONNAISSANCE and MAINTENANCE REPORT

- Description:
- Cleared by lanes bearing. **360° WITH S. INTERFERED FILES.** *Note: Cross out word or words which do not apply*
 - Mast & Vanes have been painted white & black respectively. ✓
 - The station/pillar was ~~unplaced~~/not unplaced/constructed on **3 7 19 81**, dimensions now being: Description of mark. *should be explicit, e.g. S/Steel Pillar Plate, Steel plug, Brass plug, Bolt, G.I. Pipe*
 - Height of mark. *above rock/concrete; below G.L.* Mark is **2.947** m. *above* G.L. Diameter of Top Vanes to Top Mark/Pillar-plate **2.947** m. *approx* Diameter of Vanes (vertical) **0.966** m.
 - Height of Cairn. *above* m. Diameter of Cairn. *above* m. Name Plate ~~found~~/not found/~~placed~~.
 - Length of Mast. *above* m. (approximate if not unplaced)
 - A. **CONCRETE PILE** set in conc/rock has been ~~placed~~/found, bearing. **299**°M from Mast/Plug/Pillar
 - A. **CORRAL NAIL** set in conc/rock has been ~~placed~~/found, bearing. **224**°M from Mast/Plug/Pillar
 - A. set in conc/rock has been placed/found, bearing. **0**°M from Mast/Plug/Pillar
 - A. set in conc/rock has been placed/found, bearing. **0**°M from Mast/Plug/Pillar
 - Action required: **COULD PLACE CONCRETE PILLAR. 3 STAKES NEED TO BE CLEAR.**

STANDPOINT: **NO PROBLEM WITH PERMISSION FOR PILLAR CONSTRUCTION.**

Mark	Direction	Horiz. Distance	Height Difference	Mark	Direction	Horiz. Distance	Height Difference
			above standpt.				above standpt.
			below				below
			above standpt.				above standpt.
			below				below
Prepared by: **M. Bell** Checked: **Michael Clark 28/7/81** Noted on U.T.M. Card
 S 2733-1

