

GEODETIC SURVEY OF N.S.W.

CENTRAL MAPPING AUTHORITY

GEODETIC STATION RECONNAISSANCE and MAINTENANCE REPORT

STATION: NANAIMA No.: 3322

Description: *Note: Cross out word or words which do not apply*

MAP SHEET SCALE 1:250,000 CANBERRA

1. Cleared by lances bearing..... from Trig. Mast

INSPECTED BY: G. C. HANNA DATE: 11/07/18

2. Mast & Vanes have been painted white & black respectively.

AUTHORITY: FIELD BOOK:

3. The station/pillar was unpiled/not unpiled/constructed on..... 19..... dimensions now being:

Station Diagram

Description of mark..... should be explicit, e.g., S/Steel Pillar Plate, Steel plug, Brass plug, Bolt, G.I. Pipe

Not to Scale

Height of mark..... m. above/below rock/concrete; Mark is..... m. above/below G.L.

North

Height of Top Vanes to Top Mark/Pillar plate..... m. Diameter of Vanes (vertical)..... m.

320 330 340 350 360 370 380 390 400

Height of Cairn..... m. Diameter of Cairn..... m. Name Plate found/not found/placed.

400 410 420 430 440 450 460 470 480 490 500

Length of Mast..... m. (approximate if not unpiled)

500 510 520 530 540 550 560 570 580 590 600

4. A..... set in conc/rock has been placed/found, bearing..... °M from Mast/Plug/Pillar

600 610 620 630 640 650 660 670 680 690 700

5. A..... set in conc/rock has been placed/found, bearing..... °M from Mast/Plug/Pillar

700 710 720 730 740 750 760 770 780 790 800

6. A..... set in conc/rock has been placed/found, bearing..... °M from Mast/Plug/Pillar

800 810 820 830 840 850 860 870 880 890 900

7. A..... set in conc/rock has been placed/found, bearing..... °M from Mast/Plug/Pillar

900 910 920 930 940 950 960 970 980 990 1000

8. Action required.....

1000 1010 1020 1030 1040 1050 1060 1070 1080 1090 1100

STANDPOINT:

STANDPOINT:


Mark	Direction	Horiz. Distance	Height Difference	Mark	Direction	Horiz. Distance	Height Difference
			above standpt.				above standpt.
			below standpt.				below standpt.
			above standpt.				above standpt.
			below standpt.				below standpt.
Prepared by: G. Hanna

Checked: Noted on U.T.M. Card

SI 2733-1

Checked

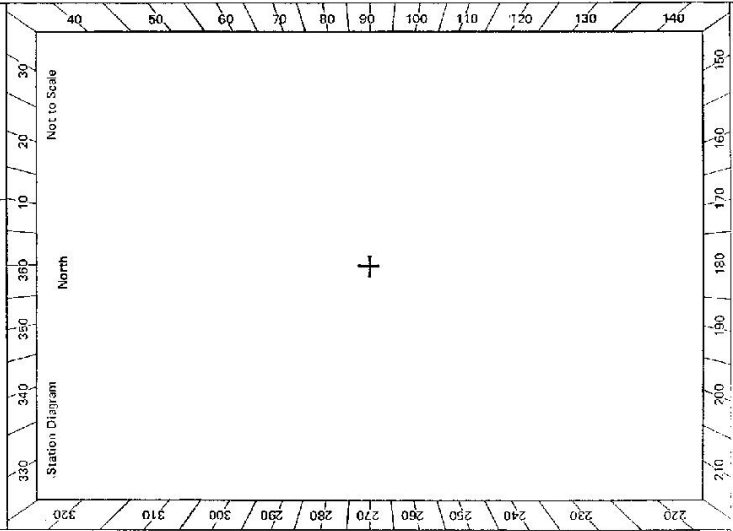

CENTRAL MAPPING AUTHORITY

GEODETIC SURVEY OF R.S.W.K.

GEODETIC STATION RECONNAISSANCE and MAINTENANCE REPORT

STATION: **Malima** No.: **3322**

MAP SHEET SCALE 1:250 000 **GOULBURN**

INSPECTED BY: **B. MITCHELL** DATE: **25/1/84**

AUTHORITY: **D.M.R.** FIELD BOOK:

Description:
 1. Cleared by lances bearing..... Note: *Cross out word or words which do not apply*..... from Trig. Mast

2. Mast & Vanes have been painted white & black respectively.

3. The station/~~with~~/not unplied/constructed on..... 19....., dimensions now being:

Description of mark..... should be explicit, e.g., S/Steel Pillar Plate, Steel plug, Brass plug, Bolt, G.I. Pipe

Height of mark..... m. ^{above}/_{below} rock/concrete; Mark is..... m. ^{above}/_{below} G.L.

Height of Top Vanes to Top Mark/Pillar plate..... m. Diameter of Vanes (vertical)..... m.

Height of Cairn..... m. Diameter of Cairn..... m. Name Plate found/not found/placed.

Length of Mast..... m. (approximate if not unplied)

4. A..... set in conc/rock has been placed/found, bearing..... ° M from Mast/Plug/Pillar

5. A..... set in conc/rock has been placed/found, bearing..... ° M from Mast/Plug/Pillar

6. A..... set in conc/rock has been placed/found, bearing..... ° M from Mast/Plug/Pillar

7. A..... set in conc/rock has been placed/found, bearing..... ° M from Mast/Plug/Pillar

8. Action required:.....

STANDPOINT:


STANDPOINT:

Mark	Direction	Horiz. Distance	Height Difference	Mark	Direction	Horiz. Distance	Height Difference
			above standpt.				above standpt.
			below				above
			above standpt.				below standpt.
			below				above standpt.
			above standpt.				below
			below				above standpt.
			above standpt.				below
			below				above standpt.
			above standpt.				below
			below				above standpt.
			above standpt.				below
			below				above standpt.

Prepared by: *Checked:*

Noted on U.T.M. Card

Checked

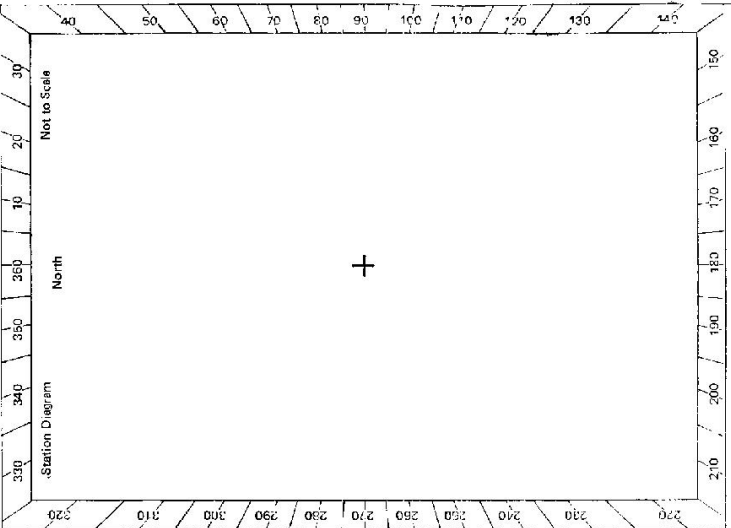

GS 24

<p>St. 2733-2 D. West, Government Printer</p>	<p>STATION G.S. 3322 NANIMA</p>	<p>Owner's Name:</p> <p>Address:</p> <p>Phone:</p>	<p>Current Occupant:</p> <p>Address:</p> <p>Phone:</p>	<p>ACCESS</p> <p>At Murrumbidgee take the Gundaroo Road for 4.4 kilometres to a gate on the right side of the road. See diagram.</p> <p>Access Report of/19..... was found suitable.</p> <p>From Murrumbidgee</p> <p>over</p> <p>to Gundaroo</p> <p>0.51 km.</p> <p>leave vehicle here</p> <p>0.27 km.</p> <p>NANIMA G.S.</p>	
<p>Beacon Diagram</p> <table border="1" style="width: 100%; height: 150px;"> <tr> <td style="width: 80%;"></td> <td style="width: 20%; text-align: center;">Not to Scale</td> </tr> </table>			Not to Scale	<p>Date</p> <p>Record of Station</p>	
	Not to Scale				
<p>This section to be completed by officer constructing pillar.</p> <p>Original station mark found/not found.</p> <p>Description of mark:</p> <p>Original beacon found/not found.</p> <p>Description of beacon:</p> <p>Height Top of Vanes to Top Mark.....m.</p> <p>Height of mark.....m. above rock/conc.....m. below G.L.</p> <p>Diameter of Vanes.....m. Height of Cairn.....m.</p> <p>Original Beacon has/has not been destroyed by me.</p>					