

7.5.19.4

Department of Lands  
 Integra Survey of N.S.W.  
**RECONNAISSANCE and MAINTENANCE REPORT**

STATION **TS NARRABEEN 3329**  
 Co: **CUMBERLAND** | Pt: **NARRABEEN**  
 Map Sheet: **TERREY HILLS** | No: **U1867**  
 Inspected by: **J.L.FLETCHER** | Date: **14.1.73**  
 Authority: **DEPT. OF LANDS** | Field Book: **68L 68**

This Trig. Station has been:-  
 Note: Cross out word or words which do not apply

1. Completely cleared to permit 360° vision to surrounding Trigs.
2. Cleared by lanes bearing..... from Trig. Mast
3. Trig. Mast & Vanes have been painted white & black respectively.
4. The Trig. was unpiled/not unpiled, dimensions now being:


Description of mark..... **TR. IN. PLUG** ..... should be explicit, e.g. Steel plug, Brass plug, Bolt, Concrete Pillar  
 Height of mark..... **0.025** m <sup>above</sup> rock/concrete..... m <sup>below</sup> G.L.  
 Height of Top Vanes to Top Mark/Top-pillar-plate **2.41** m Diameter of Vanes (vertical)..... m.  
 Height of Cairn..... m. Diameter of Cairn..... m.  
 Length of Mast **2.435** m. (approximate if not unpiled)

5. A..... set in conc/rock has been placed/fd ..... m, bearing .....°M from Trig. Mast/pillar
6. A..... set in conc/soil has been placed/fd ..... m, bearing .....°M from Trig. Mast/pillar
7. A..... set in conc/soil has been placed/fd ..... m, bearing .....°M from Trig. Mast/pillar
8. A..... set in conc/rock has been placed/fd ..... m, bearing .....°M from Trig. Mast/pillar

9. Connection..... to..... m, bearing.....°M
10. Connection..... to..... m, bearing.....°M
11. Connection..... to..... m, bearing.....°M
12. Connection..... to..... m, bearing.....°M
13. Diff. Ht. .... is..... m, <sup>above</sup>/<sub>below</sub>.....
14. Diff. Ht. .... is..... m, <sup>above</sup>/<sub>below</sub>.....
15. Diff. Ht. .... is..... m, <sup>above</sup>/<sub>below</sub>.....
16. Diff. Ht. .... is..... m, <sup>above</sup>/<sub>below</sub>.....

Prepared by: Sheela Checked: BT

Beacon Diagram  
 Not to Scale

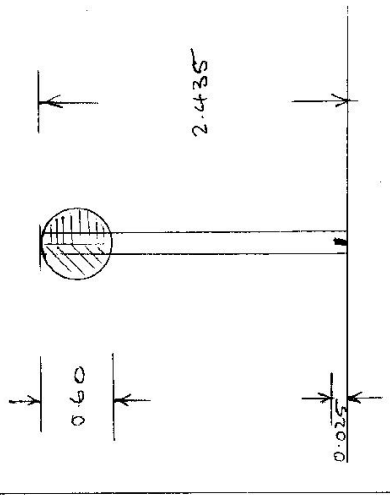

Date	Record of Station
14.1.73	Thin station visited for EDM measurements
	4 angles observed
	These reported 22.6.73



Integral Survey of N.S.W.

RECONNAISSANCE and MAINTENANCE REPORT 3329

Department of Lands

STATION NARRABEEN [PT] TS 3329

This Trig. Station has been:- Note: Cross out word or words which do not apply

Co: Cumbeyland. Ph: NARRABEEN

1. Completely cleared to permit 360° vision to surrounding Trigs.

Map Sheet: Frenchs Forest 1:10000 No: U 1867

2. Cleared by James bearing

Inspected by: P. HARCUMBE Date: 6/8/81

3. Trig. Mast & Vanes have been painted white & black respectively.

from Trig. Mast

4. The Trig. was unpiled/not unpiled, dimensions now being:

Description of mark: STEEL PILLAR should be explicit, e.g. Steel plug, Brass plug, Bolt, Concrete Pillar

Height of mark: 1.17 m above below 1.32 m above G.L.

Height of Top Vanes to Top Mast/Top pillar plate: 1.45 m Diameter of Vanes (vertical): 0.6 m.

Height of Cairn: m. Diameter of Cairn: m.

Length of Mast: m. (approximate if not unpiled)

5. AN OLD PLUG set in conc/rock has been placed/fd 1.16 m. bearing 250 °M from Trig. Mast/pillar

6. A LEAD PLUG set in conc/soil has been placed/fd 27.77 m. bearing 12 °M from Trig. Mast/pillar

7. A set in conc/soil has been placed/fd m. bearing °M from Trig. Mast/pillar

8. A set in conc/rock has been placed/fd m. bearing °M from Trig. Mast/pillar

9. Connection: PILLAR to OLD PLUG: 1.16 m. bearing 250 °M

10. Connection: PILLAR to PLUG: 27.77 m. bearing 12 °M

11. Connection: OLD PLUG to PLUG: 20.565 m. bearing 15 °M

12. Connection: to m. bearing °M

13. Diff. Ht. OLD PLUG is 1.19 m. above below PILLAR PLATE

14. Diff. Ht. LEAD PLUG is 10.937 m. above below PILLAR PLATE


15. Diff. Ht. OLD PLUG is 9.638 m. above below LEAD PLUG

16. Diff. Ht. is m. above below

Prepared by: Paul R. Harcombe Checked: JWA

Beacon Diagram

Not to Scale

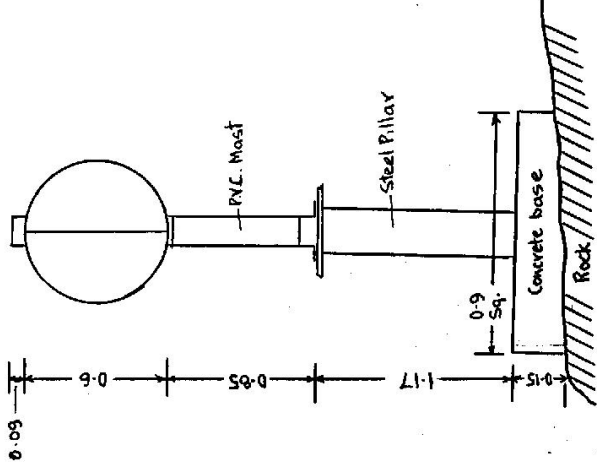

Date	Record of Station
16-7-81	Pillar, Mast & Vanes Erected - P. Harcombe
6-8-81	WITNESS MARKS CONNECTED - P. HARCUMBE

STATIONTS 3329 NARRABEEN (P)

Owners Name: WARRINGAH RADIO CONTROL SOCIETY


Current Occupant:

Address:


Address:

6/8/1981

Access: 4 WD Vehicle Key required to locked gate. FROM INTEGRATION SURVEYS From Intersection Forest Way & Morgan Rd travel until Kameragal Restaurant is reached on LHS of road. Turn left onto gravel road immediately after restaurant. Travel 4 kms until TS. is reached.

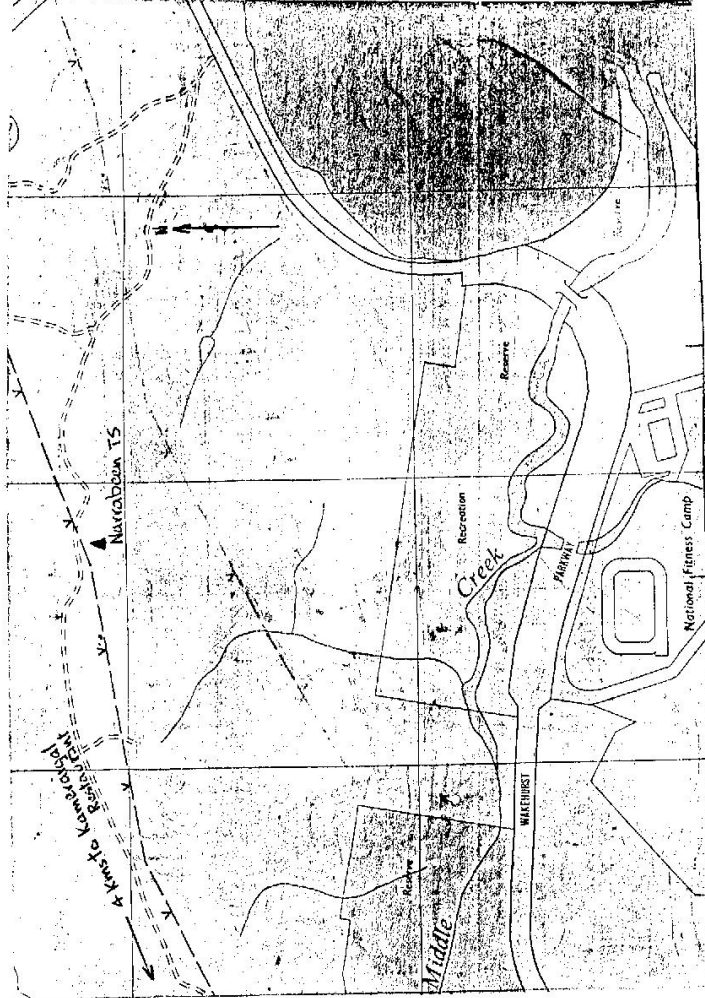

Station Diagram Not to Scale

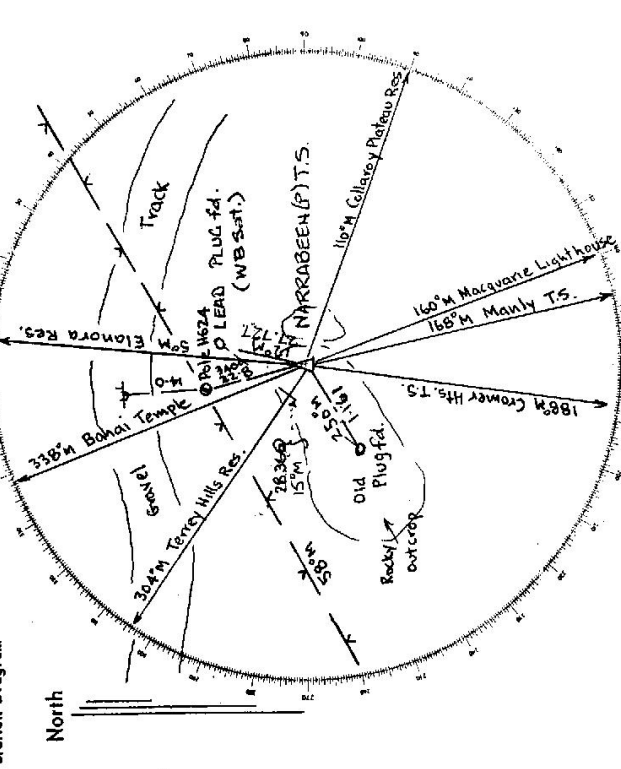

List of Observed Directions:- FB01 1531/M

Station	Direction	Station	Direction
ELANORA TS	15 00 00	OLD PLUG	250 07 54
MANLY TS	177 14 19	LEAD PLUG (W.B. SAT.)	12 32 45
CROMER HTS TS	196 15 11		
BELROSE TS	255 16 47		
TERREY HILLS TS	310 53 31		
CONTINUED NEXT COLUMN			
Station	Direction	Station	Direction

Standpoint: NARRABEEN PILLAR Standpoint: NARRABEEN PILLAR