

GEODETTIC SURVEY OF N.S.W.

CENTRAL MAPPING AUTHORITY

GEODETTIC STATION RECONNAISSANCE and MAINTENANCE REPORT

Description:

Note: Cross out word or words which do not apply

1. Cleared by lances bearing..... from Trig. Mast
2. Mast & Vanes have been painted white & black respectively.
3. The station/pillar was unpiled/not unpiled/constructed on..... 19....., dimensions now being: Description of mark..... should be explicit, e.g., S/Steel Pillar Plate, Steel plug, Brass plug, Bolt, G.I. Pipe
- Height of mark..... m. ^{above} rock/concrete; Mark is m. ^{above} G.L.
- Height of Top Vanes to Top Mark/Pillar plate m. Diameter of Vanes (vertical)..... m.
- Height of Cairn..... m. Diameter of Cairn..... m. Name Plate found/not found/placed.
- Length of Mast..... m. (approximate if not unpiled)
4. A..... set in conc/rock has been placed/found, bearing..... ° M from Mast/Plug/Pillar
5. A..... set in conc/rock has been placed/found, bearing..... ° M from Mast/Plug/Pillar
6. A..... set in conc/rock has been placed/found, bearing..... ° M from Mast/Plug/Pillar
7. A..... set in conc/rock has been placed/found, bearing..... ° M from Mast/Plug/Pillar
8. Action required.....

STANDPOINT:

Mark	Direction	Horiz. Distance	Height Difference	Mark	Direction	Horiz. Distance	Height Difference
			above standpt.				above standpt.
			below				below
			above standpt.				above standpt.
			below				below
Prepared by: *[Signature]*

Checked: *[Signature]*

Noted on U.T.M. Card

st 2753-1

STATION: *NARRAWIDGERY GS* TS No.: *3342*

MAP SHEET SCALE 1:250 000

INSPECTED BY: *M. J. PETERSON* DATE: *5/3/75*

AUTHORITY: *C.M.A.* FIELD BOOK: *—*

Station Diagram

North

320 310 300 290 280 270 260 250 240 230 220 210 200 190 180 170 160 150

330 340 350 360 370 380 390 400

Not to Scale

*Royal Artillery Camp, Plogoe
The F404 found. R.M. RMZ
and R.M. B all found.
No barbed bescon found.
Marks painted yellow.*

+

Checked

PM's and SSM's placed under Survey Practice Regulations 12 and 55B are required to have a Locality Sketch Plan lodged with the Deposited Plan at The Land Titles Office.

D.P. _____




TS 3342
Description NARRAWIDGERY T.S. (E 404)

LOCALITY SKETCH PLAN

Parish HAY SOUTH County WARADGERY Town/Suburb/Locality 9km South Hay
Municipality or Shire HAY C.M.A. Map Sheet HAY 7828 I & IV

Measurements are in metres

Zone 55/1

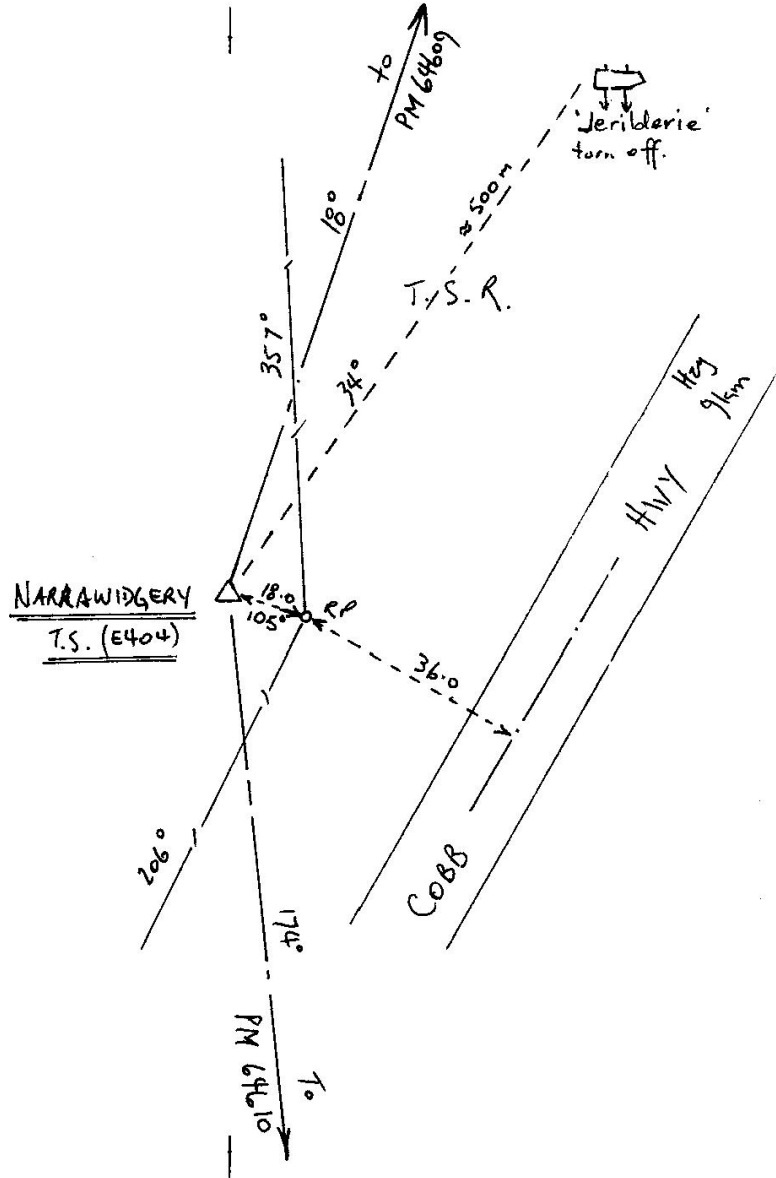

Organization placing Marks _____

Ref. 5918

I certify that the Mark or Marks have been placed and numbered as detailed herein.

The Surveyor General is to be notified of ISG/AMG Co-Ordinates and/or AHD Levels determined by survey for mark placed.

M. Carrax
Mark placed 20 / 7 / 19 88



S.O. 2 019

Replaces PM _____
SSM _____

LAND INFORMATION CENTRE

GEODETIC SURVEY OF N.S.W.

GEODETIC STATION RECONNAISSANCE and MAINTENANCE REPORT

STATION: *NARRAWIDGGERY* No.: *3342*

MAP SHEET SCALE 1:250000 *HAY 7828 THE* 1:50,000

INSPECTED BY: *MORRISON* DATE: *5/8/1999*

AUTHORITY: *LIC* FIELD BOOK: *—*

Description: *Note: Cross out word or words which do not apply*

1. Cleared by lanes bearing..... from Trig. Mast

2. Mast & Vanes have been painted white & black respectively.

3. The station/pillar was unpiled/not unpiled/constructed on..... dimensions now being:

Description of mark..... should be explicit, e.g. S/Steel Pillar Plate, Steel plug, Brass plug, Bolt, G.I. Pipe

Height of mark..... m. above below rock/concrete; Mark is *0.1* m. above below G.L.

Height of Top Vanes to Top Mark/Pillar plate..... m. Diameter of Vanes (vertical)..... m.

Height of Cairn..... m. Diameter of Cairn..... m. Name-Plate found/not found/placed.

Length of Mast..... m. (approximate if not implied)

4. A..... set in conc/rock has been placed/found, bearing.....° M from Mast/Plug/Pillar
5. A..... set in conc/rock has been placed/found, bearing.....° M from Mast/Plug/Pillar
6. A..... set in conc/rock has been placed/found, bearing.....° M from Mast/Plug/Pillar
7. A..... set in conc/rock has been placed/found, bearing.....° M from Mast/Plug/Pillar

8. Action required:.....

STANDPOINT:

Mark	Direction	Horiz. Distance	Height Difference	Mark	Direction	Horiz. Distance	Height Difference
			above standpt.				above standpt.
			below				below
			above standpt.				above standpt.
			below				below
Prepared by: *[Signature]* 12/8/99 Checked: *[Signature]* Based on U.T.M. Grid

Checked

ST 2733-2 D. West Government Printer

Not to Scale

Beacon Diagram

Height of mark: m.

Height of Top of Vanes to Top Mark: m.

Height of mark: m. above rock/cons. above G.L.

..... m. below

Diameter of Vanes: m. Height of Cairn: m.

Original Beacon has/has not been destroyed by me.

This section to be completed by officer constructing pillar.

Original station mark found/not found:

Description of mark:

Original beacon found/not found:

Description of beacon:

Height Top of Vanes to Top Mark: m.

Height of mark: m. above rock/cons. above G.L.

..... m. below

Diameter of Vanes: m. Height of Cairn: m.

Original Beacon has/has not been destroyed by me.

		STATION <u>MARAWIDGERY</u> <u>3342</u>	
		Owner's Name:	Current Occupant:
		Address:	Address:
		Phone:	Phone:
		Access Report of '18: was found suitable/unsuitable.	ACCESS <u>5/8/1999</u>
		<u>Km</u> <u>Direction</u>	
		<u>0.0</u> <u>Hwy Post Office</u> <u>Head South to South Hwy</u>	
		<u>1.2</u> <u>Through Roundabout + follow road Hwy towards Derrinquin</u>	
		<u>2.7</u> <u>Pass Hwy Airport on your right</u>	
		<u>5.4</u> <u>Pass Hay Ridge SLD on your left</u>	
		<u>8.8</u> <u>Pass rd to Jerilderie on your left</u>	
		<u>9.05</u> <u>Turn right off Hwy towards fence corner</u>	
		<u>9.10</u> <u>(*Be aware table drain boggy when wet)</u>	
		<u>Marawidgerly Trig</u> <u>abt 20m from fence</u>	
		<u>corner in road</u>	
Date	Record of Station		