

GEODETTIC SURVEY OF M.S.W.

CENTRAL MAPPING AUTHORITY

GEODETTIC STATION RECONNAISSANCE and MAINTENANCE REPORT

- Description: *Note: Cross out word or words which do not apply*
1. Cleared by lanes bearing..... from Trig. Mast
 2. Mast & Vanes have been painted white & black respectively.
 3. The station/~~marker~~ was ~~used~~/not unplied/~~used~~ on.....19....., dimensions now being: Description of mark.....should be explicit. e.g., S/Steel Pillar Plate, Steel plug, Brass plug, Bolt, G.I. Pipe
 Height of mark.....m. above rock/concrete; Mark is.....m. above G.L.
 Height of Top Vanes to Top Mark/Pillar platem. Diameter of Vanes (vertical).....m.
 Height of Cairn.....m. Diameter of Cairn.....m. Name Plate found/not found/placed.
 Length of Mastm. (approximate if not unplied)
 4. A.....set in conc/rock has been placed/found, bearing.....°M from Mast/Plug/Pillar
 5. A.....set in conc/rock has been placed/found, bearing.....°M from Mast/Plug/Pillar
 6. A.....set in conc/rock has been placed/found, bearing.....°M from Mast/Plug/Pillar
 7. A.....set in conc/rock has been placed/found, bearing.....°M from Mast/Plug/Pillar
 8. Action required:.....

STANDPOINT: *Key/Heath*

Mark	Direction	Horiz. Distance	Height Difference	Mark	Direction	Horiz. Distance	Height Difference
			above standpt.				above standpt.
			below				below
			above standpt.				above standpt.
			below				below
Prepared by: *Key/Heath* Checked: *Key/Heath* *Noted on U.T.M. Card*

St 2733-1

STATION: **MATTUNG** No: **3350**

MAP SHEET SCALE 1:250 000 **CAMBERRA**

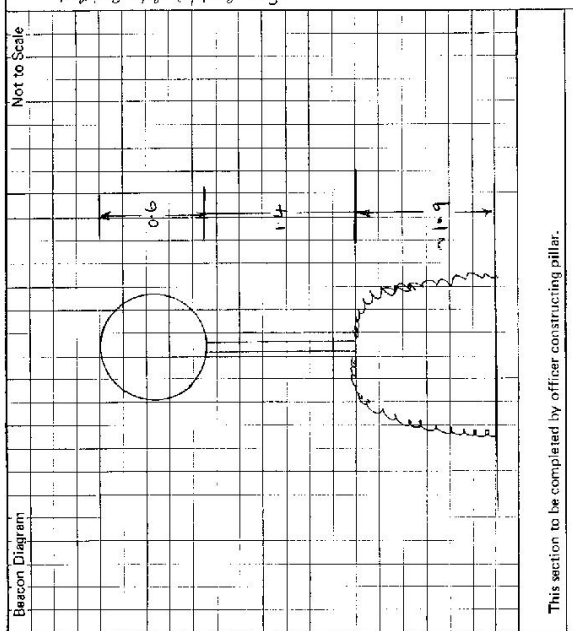
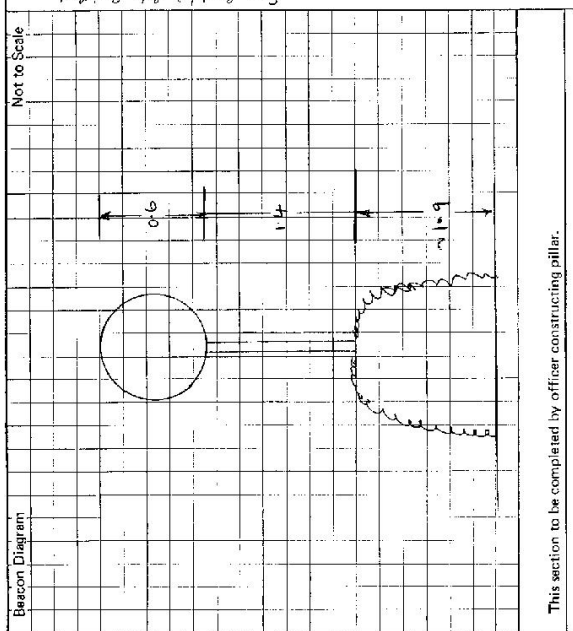
INSPECTED BY: **K. HADDOON** DATE: **March 1979**

AUTHORITY: **C.M.A** FIELD BOOK:

Station Diagram

Not to Scale

Checked

<p>ST 2733-2 D. West, Government Printer</p>	<p>Beacon Diagram</p>  <p>Not to Scale</p>	<p>STATION NATUNGA IS 3350</p>	<p>Owner's Name: <u>Kasasiasu Natunaga Peak</u> March 1979 Current Occupant:</p>
<p>This section to be completed by officer constructing pillar.</p> <p>Original station mark found/not found.</p> <p>Description of mark:</p> <p>Original beacon found/not found.</p> <p>Description of beacon:</p> <p>Height Top of Vanes to Top Markm. abovem. below G.L. belowm.</p> <p>Diameter of Vanesm. Height of Cairnm.</p> <p>Original Beacon has/has not been destroyed by me.</p>		 <p>Scale: 1:25000</p> <p>See Tentative Rules Part 123000</p>	<p>Date: <u>March 1979</u></p> <p>Record of Station: <u>Visual 360° Vision available with clearing</u></p>