

GEODETTIC SURVEY OF M.S.W

CENTRAL MAPPING AUTHORITY

GEODETTIC STATION RECONNAISSANCE and MAINTENANCE REPORT

Description: *Note: Cross out word or words which do not apply*

1. Cleared by lanes bearing..... from Trig, Mast
2. Mast & Vanes have been painted white & black respectively.
3. The station/pillar was unpiled/not unpiled/constructed on.....19....., dimensions now being: Description of mark.....should be explicit, e.g., S/Steel Pillar Plate, Steel plug, Brass plug, Bolt, G.I. Pipe
 Height of mark.....m.....^{above}/_{below} rock/concrete: Mark is.....m.....^{above}/_{below} G.L.
 Height of Top Vanes to Top Mark/Pillar platem. Diameter of Vanes (vertical).....m.
 Height of Cairn.....m. Diameter of Cairn.....m. Name Plate found/not found/placed.
 Length of Mastm. (approximate if not unpiled)
4. A.....set in conc/rock has been placed/found, bearing.....°M from Mast/Plug/Pillar
5. A.....set in conc/rock has been placed/found, bearing.....°M from Mast/Plug/Pillar
6. A.....set in conc/rock has been placed/found, bearing.....°M from Mast/Plug/Pillar
7. A.....set in conc/rock has been placed/found, bearing.....°M from Mast/Plug/Pillar
8. Action required.....

STANDPOINT:

Mark	Direction	Horiz. Distance	Height Difference	Mark	Direction	Horiz. Distance	Height Difference
			above standpt.				above standpt.
			below				below
			above standpt.				above standpt.
			below				below
Prepared by: *[Signature]* Checked: *[Signature]*

Noted on U.T.M. Card


St. 2739-1

STATION: NEVILLE No.: 3365

MAP SHEET SCALE 1:250 000 GRAFTON

INSPECTED BY: M.L. Pearson DATE: 12/10/79

AUTHORITY: CMA FIELD BOOK: 1798

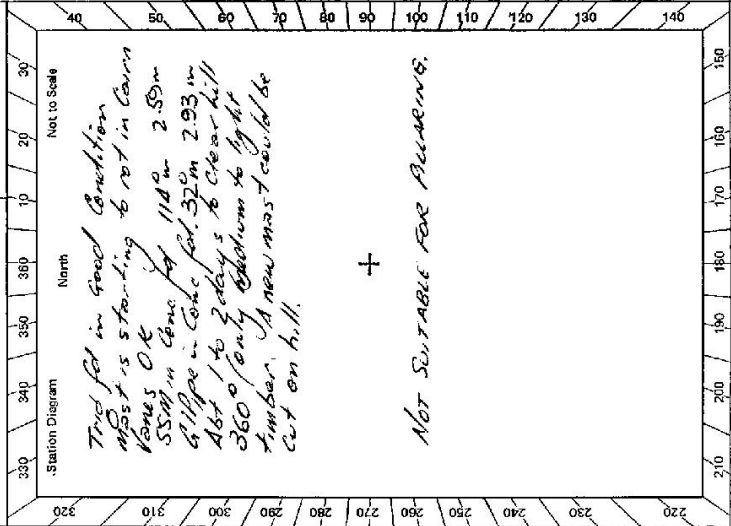

Checked

G

512733-2 D. West, Government Printer

<p>Owner's Name: CROWN LAND Address: Phone:</p>	<p>Current Occupant: Address: Phone:</p>	<p>STATION NEVILLE IS 3365</p>	
<p>ACCESS</p>			
<p>Access Report of 14/10/19, that was found suitable/unsuitable, BY <u>DIRECTION</u></p>			
<p>0.00 0.23 5.08 13.16 16.87 17.27 17.55 18.74 21.68 25.53 29.08</p>	<p>HEAD SOUTH TAKE RIGHT HAND FORK BUSBY'S FLAT "AKAPENE" "NYAN" TURN LEFT AT 'T' JUNCTION SIGN CAPTIONED "CAMIRACK IS WHIRBURLIE" PASS WHINCK ROAD ON RIGHT TURN RIGHT INTO BREWERS ROAD TURN LEFT ON TO TRACK WIRE GATE GATE PASS TRACK TO THE RIGHT (KEEP TO LEFT OF FENCE LINE) TURN HARD RIGHT THROUGH GATEWAY FOLLOW TRACK. PARK TRUCK NEXT TO FENCE LINE (OLD) HEAD UP ROAD, FOLLOW THIS FENCE LINE TO A LEFT HAND BEND THEN FOLLOW BLAZES TAKING OFF TO THE RIGHT. FOLLOW BLAZES UP V STEEP SLOPE TO A PLACE ON THE ROCK FACE WHERE IT IS EASY TO GET UP. WALK ALONG TOP OF RIDGE TO TRAIL IS EASY. COMMENCE WALK WITHOUT LOAD. APPROX 1 HOUR WALK WITH LOAD (V STEEP NEAR TOP. GEAR WOULD HAVE TO BE MAN MANAGED)</p>		
<p>Beacon Diagram</p> <div style="border: 1px solid black; width: 300px; height: 150px; margin: 10px 0;"> </div> <p style="text-align: right; margin-right: 50px;">Not to Scale</p>			
<p>This section to be completed by officer constructing pillar.</p> <p>Original station mark found/not found.</p> <p>Description of mark:</p> <p>Original beacon found/not found.</p> <p>Description of beacon:</p> <p>Height Top of Vanes to Top Markm.</p> <p>Height of mark.....m. above G.L. below G.L.</p> <p>Diameter of Vanesm. Height of Cairnm.</p> <p>Original Beacon has/has not been destroyed by me.</p>			
		Date	Record of Station

CENTRAL MAPPING AUTHORITY

GEODETIC SURVEY OF N.S.W.
 GEODETIC STATION RECONNAISSANCE and MAINTENANCE REPORT


STATION: NEVILLE G.S. No.: 3365

MAPSHEET SCALE 1:250 000

INSPECTED BY: L.R. HOLLIS

DATE: 5 July 2011

AUTHORITY: C.M.A. FIELD BOOK: 1811

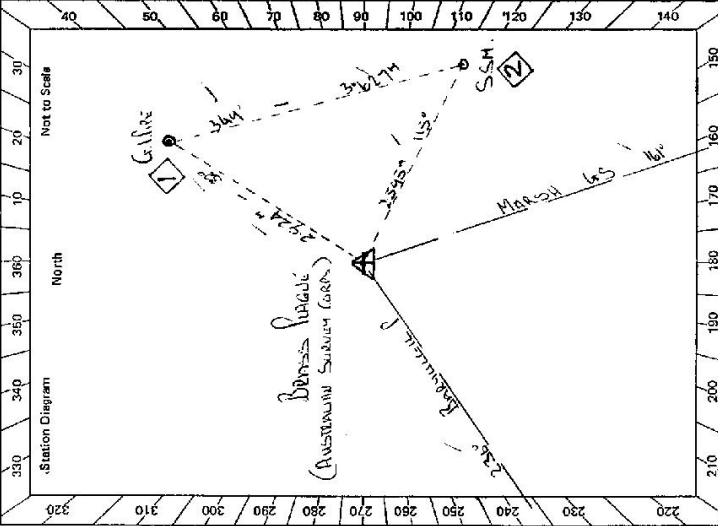

- Description:
- Cleared by lanes bearing 360° . Note: Cross out word or words which do not apply
 - Mast & Vanes have been painted white & black respectively. ✓
 - The station/pillar was unpiled/constructed on $3.1 \times 1.1 \times 1.1$ m. 19.80 m. dimensions now being:
 - Description of mark: BONES LAQUE should be explicit, e.g. S/Steel Pillar Plate, Steel plug, Brass plug, Bolt, G.I. Pipe
 - Height of mark: 0.80 m. above rock/concrete; Mark is 1.08 m. above G.L.
 - Height of Top Vanes to Top Mark: 1.15 m. Diameter of Vanes (vertical): 3.70 m.
 - Height of Cairn: 0.10 m. Diameter of Cairn: 0.50 m. Name Plate found/lost/removed/placed.
 - Length of Mast: 3.10 m. (approximate if not specified)
 - A. S.S.M. set in conc/rock has been placed/found, bearing $132^\circ 45'$ M from Mast/Plug/Pillar
 - A. G.I.P. set in conc/rock has been placed/found, bearing 360° M from Mast/Plug/Pillar
 - A. set in conc/rock has been placed/found, bearing $132^\circ 45'$ M from Mast/Plug/Pillar
 - A. set in conc/rock has been placed/found, bearing $132^\circ 45'$ M from Mast/Plug/Pillar

STANDPOINT: BONES LAQUE				STANDPOINT: S.S.M.			
Mark	Direction	Horiz. Distance	Height Difference	Mark	Direction	Horiz. Distance	Height Difference
MARSH G.S.	0 00 00		above standpt.	MARSH G.S.	0 00 00		above standpt.
BARWILLI P	75 12 40		above standpt.	BARWILLI P	75 12 50		above standpt.
G.I.P.	232 41 00	2.927	below standpt.	BONES LAQUE	134 34 35	2.595	below standpt.
S.S.M.	314 34 00	2.595	above standpt.	G.I.P.	187 32 50	3.627	below standpt.
			below standpt.				above standpt.
			above standpt.				below standpt.
			below standpt.				above standpt.
			above standpt.				below standpt.

Prepared by: L.R. Hollis
 Checked: P. Kelly 9/7/11
 Noted on U.T.M. Card

STATION NEVILLE GS TS 3365	Owner's Name: Current Occupant: COACHMAN Address: Phone: Phone: ACCESS Access Report of 5.1.1988 was found suitable/unsuitable.
Beacon Diagram Not to Scale 	Feature RMTVILLE P.O. HEAD SOUTH / TAKE R.H. FENCE BUSBY'S FLAT "PUMPHOUSE" WYMAN / TURN LEFT AT "JUNCTION" SIGN "EASTON 50" "CAMMERS" "WHITFIELD 18" / PASS WOOD CREEK ROAD ON R.H.S. / TURN RIGHT INTO "BOSWELL'S RD." / TURN LEFT ON TO TRACK "WIRE END" / GATE / PASS TRACK ON RIGHT (V. LEFT OF FENCE LINE) / TURN HEAD RIGHT THROUGH LANE WAY, FOLLOW TRACK / LEAVE VEHICLE NEXT TO OLD FENCE LINE, FOLLOW ROAD R.H.S. FENCE FOLLOWING BLAZES UP VERY VERY SLOPE BUSHY FENCE ABOUT 50 Mtrs WALK.
This section to be completed by officer constructing pillar. Original station mark found/not found. Description of mark: As Above Original beacon found/not found. Description of beacon: Height: Top of Vanes to Top Markm. Height of markm. above G.L. below G.L. Diameter of Vanesm. Height of Cairnm. Original Beacon has/has not been destroyed by me.	Date Record of Station

8: 2733-2 D. West. Groundmark Printer