

GEODETIC SURVEY OF N.S.W.

CENTRAL MAPPING AUTHORITY

GEODETIC STATION RECONNAISSANCE and MAINTENANCE REPORT

Description:

Note: Cross out word or words which do not apply

1. Cleared by lines bearing..... 14 - 250 M, 34 - 78 M, 89 - 3 M, ..... from Trig. Mast  
 Original Trig Mast Placed using ORIGINAL VANES.  
 Mast & Vanes have been painted white & black respectively.  
 Partly replaced was replaced/constructed on..... 19.87, dimensions now being:
3. The station..... should be explicit, e.g., S/Steel Pillar Plate, Steel plug, Brass plug, Bolt, G.I. Pipe
- Description of mark..... Mark is..... m. above G.L.
- Height of mark..... m. above rock/concrete; Diameter of Vanes (vertical)..... 750 m.
- Height of Top Vanes to Top Mark/Pillar plate..... 1.9 M TOP, 6.4 M Name Plate found/not found/placed.
- Height of Cairn..... 1.6 m. Diameter of Cairn..... 2.00 m.
- Length of Mast..... 2.680 m. (approximate if not certified)
4. A..... set in conc/rock has been placed/found, bearing..... ° M from Mast/Plug/Pillar
5. A..... set in conc/rock has been placed/found, bearing..... ° M from Mast/Plug/Pillar
6. A..... set in conc/rock has been placed/found, bearing..... ° M from Mast/Plug/Pillar
7. A..... set in conc/rock has been placed/found, bearing..... ° M from Mast/Plug/Pillar
8. Action required:.....

STANDPOINT:

Mark	Direction	Horiz. Distance	Height Difference	Mark	Direction	Horiz. Distance	Height Difference
			above standpt				above standpt
			below				below
			above standpt				above standpt
			below				below
STANDPOINT:

Mark	Direction	Horiz. Distance	Height Difference
			above standpt
			below
			above standpt
			below
Prepared by:

Checked: 10/11/22 22.16.9"

Noted on U.T.M. Card

Checked

STATION: **NEWHAM G.S.** No.: **3367**  
 MAP SHEETS: **SCALE 1:100 000**  
 SCALE: **1:250 000** **GOULBURN.**  
 INSPECTED BY: **D. J. Kain** DATE: **1. 6. 1987.**  
 AUTHORITY: **C. M. A.** FIELD BOOK: **C.00511**

Station Diagram

North

Not to Scale

Note Re access: - **Owner Mr Osborne will show any C.M.A. Personnel access to within 10 minute walk of this station providing he is contacted with at least One Day notice.**  
**With further investigation could be possible with 4 wheel drive vehicle to drive to station.**

GS 24

STATION **NEWHAM** C. G. **TS 3367**



Owner's Name: **MR. BEN O'BORNE** ✓  
 Current Occupant: **MR. RICK CARWRIGHT**

Address: **MARYAMMA CT**  
**WYANGALA**

Phone: **(062) 4507 EXTENSION 8** /  
**1-6-1987**

Phone: **(062) 4507 EXTENSION 30** /

**ACCESS**  
**KOORAWATHA 8629-I & IV FIRST EDITION 1:50 000 SERIES**

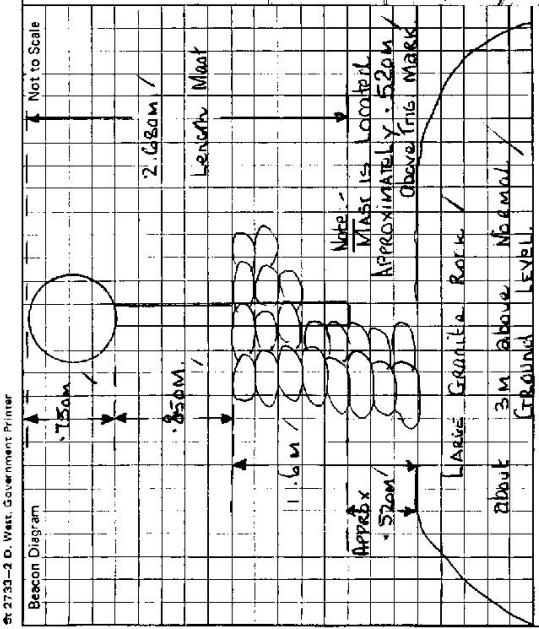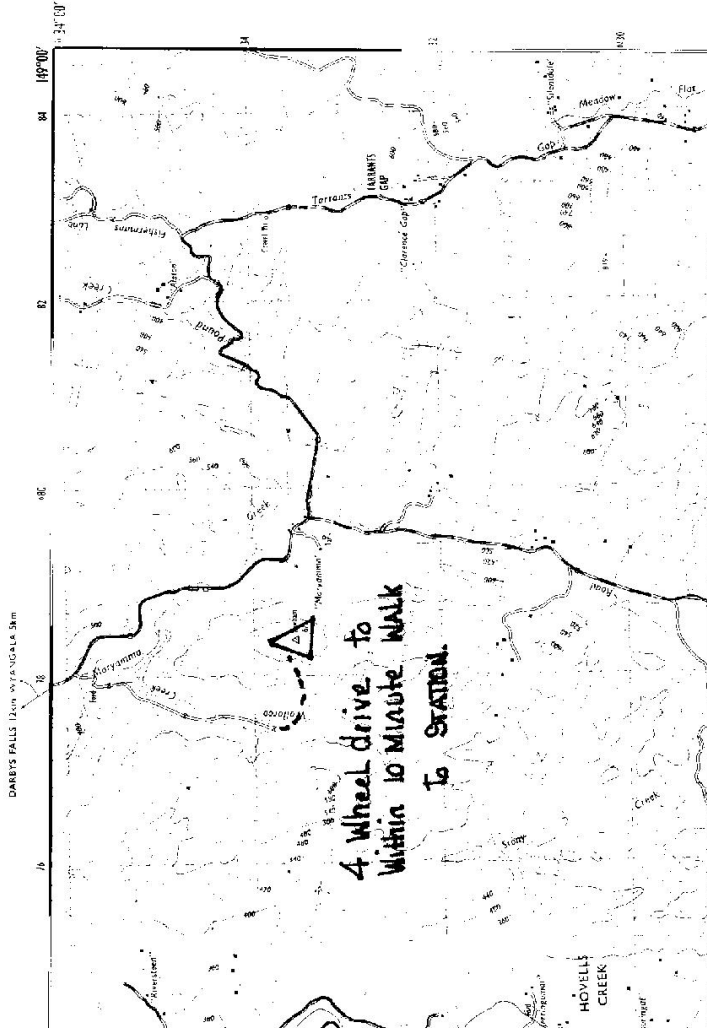

This section to be completed by officer constructing pillar.

Original station mark found/not found. ....

Description of mark: .....

Original beacon found/not found. ....

Description of beacon: .....

Height Top of Vanes to Top Mark .....m.  
 above below

Height of mark .....m. rock/conc .....m. above G.L. below

Diameter of Vanes .....m. Height of Cairn .....m.

Original Beacon has/has not been destroyed by me.