

GEODETIC SURVEY OF N.S.W.

CENTRAL MAPPING AUTHORITY

GEODETIC STATION RECONNAISSANCE and MAINTENANCE REPORT

Description:

Note: Cross out word or words which do not apply

1. Cleared by lanes bearing..... 34.2° Heavy Timber..... from Trig. Mast
2. Mast & Vanes have been painted white & black respectively.
3. The station/pillar was unpiled/not unpiled/constructed on..... 19....., dimensions now being:
Description of mark..... brass plug..... should be explicit, e.g., S/Steel Pillar Plate, Steel plug, Brass plug, Bolt, G.I. Pipe
Height of mark..... 0.15 m. ^{above} rock/concrete; Mark is..... 0.15 m. ^{above} G.L.
Height of Top Vanes to Top Mark/Pillar plate..... 0.15 m. Diameter of Vanes (vertical)..... 0.15 m.
Height of Cairn..... 0.15 m. Diameter of Cairn..... 0.15 m. Name Plate found/not found/placed.
Length of Mast..... 0.15 m. (approximate if not unpiled)
4. A..... set in conc/rock has been placed/found, bearing..... °M from Mast/Plug/Pillar
5. A..... set in conc/rock has been placed/found, bearing..... °M from Mast/Plug/Pillar
6. A..... set in conc/rock has been placed/found, bearing..... °M from Mast/Plug/Pillar
7. A..... set in conc/rock has been placed/found, bearing..... °M from Mast/Plug/Pillar
8. Action required:.....

STANDPOINT:

Mark	Direction	Horiz. Distance	Height Difference	Mark	Direction	Horiz. Distance	Height Difference
			above standpt.				above standpt.
			below				below
			above standpt.				above standpt.
			below				below
STANDPOINT:

Mark	Direction	Horiz. Distance	Height Difference
			above standpt.
			below
			above standpt.
			below
Prepared by: W. Miller

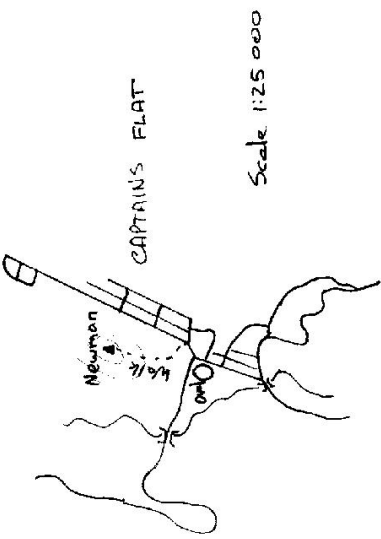
Checked: 18.12.15

Noted on U.T.M. Card

Checked

STATION: **NEWMAN** No.: **3369**
 MAP SHEET SCALE 1:250 000 **CANBERRA**
 INSPECTED BY: **W. MILLER** DATE: **27.11.18**
 AUTHORITY: **CMA** FIELD BOOK:

Station Diagram
North
Not to Scale

STATION NEWMAN TX 3369	Owner's Name: Address: Phone: Current Occupant: Address: Phone: Access Report of <u>27.11.1978</u> was found suitable/unsuitable. ACCESS
Beacon Diagram Not to Scale Aile of rocks only.	
This section to be completed by officer constructing pillar. Original station mark found/not found. Description of mark: Original beacon found/not found. Description of beacon: Height Top of Vanes to Top Markm. Height of markm. above/below G.L. Diameter of Vanesm. Height of Cairnm. Original Beacon has/has not been destroyed by me.	Date 27.11.78 Record of Station Station <u>Stable</u> <u>As per plan</u>

81 2733-2 D. West, Government Printer