

GEODETIC SURVEY OF N.S.W.

CENTRAL MAPPING AUTHORITY

GEODETIC STATION RECONNAISSANCE and MAINTENANCE REPORT

STATION: NEW YEAR G.S. No.: 3374


MAP SHEET SCALE 1:250 000 BOURKE

INSPECTED BY: D. FREDRIKSEN DATE: 30/6/79

AUTHORITY: C. M. A. FIELD BOOK: 1572

Description: *Note: Cross out word or words which do not apply*

1. Cleared by Vanes bearing... *About 1/2 days... clearing... for... 360... from Trig. Mast*
2. Mast & Vanes have been painted white & black respectively.
3. The station/pillar was ~~unpiled/reconstructed~~ on... *30.6.19... 19... dimensions now being:*  
 Description of mark... *should be explicit, e.g., S/Steel Pillar Plate, Steel plug, Brass plug, Bolt, G.I. Pipe*  
 Height of mark... *above below* rock/concrete; Mark is... *above below* G.L.  
 Height of Top Vanes to Top Mark/Pillar plate .....m. Diameter of Vanes (vertical) *0.745m.*  
 Height of Cairn... *2.1... m. Diameter of Cairn... 2.5... m. Name Plate found/not found/Replaced.*  
 Length of Mast... *3.7... m. (approximate if not unpiled)*
4. A..... *set in conc/rock has been placed/found, bearing..... °M from Mast/Plug/Pillar*
5. A..... *set in conc/rock has been placed/found, bearing..... °M from Mast/Plug/Pillar*
6. A..... *set in conc/rock has been placed/found, bearing..... °M from Mast/Plug/Pillar*
7. A..... *set in conc/rock has been placed/found, bearing..... °M from Mast/Plug/Pillar*
8. Action required: *clearing... satellite marks... pld., mast & vanes... need... painting.....*

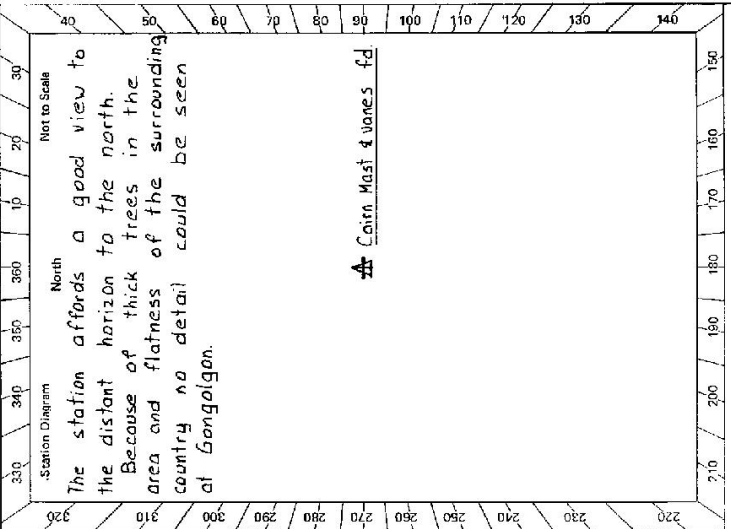

STANDPOINT:

Mark	Direction	Horiz. Distance	Height Difference	Mark	Direction	Horiz. Distance	Height Difference
			above standpt.				above standpt.
			below				below
			above standpt.				above standpt.
			below				below
Prepared by: D. FREDRIKSEN 4/9/79 Checked: *[Signature]* Noted on: U.T.M. Cart

**STATION NEW YEAR 6.S TS 3374**

Owner's Name: **GREG M. MULLEN** Current Occupant: .....

Address: **GONGOLGON** Address: .....

**BREWARRINA** Phone: .....

Phone: **Gongolgon 14** Phone: **30-6-1979**

clearing and access permission @kd ACCESS 30-6-1979

Access-Report of **19-10-1979** was found suitable for installation.

Feature

Kms	At turn off just south of Gongolgon take the
0.0	"COOLABAH B5" road. (bitumen)
3.5	Grid
7.7	Grid
* 10.4	Grid and track on R.H.S. (alternative access)
13.9	Take faint track on R.H.S. just opposite (S) signpost
15.6	Track is badly eroded in places
17.8	Thru wire gate
18.5	Pass "Graigo Tank" on L.H.S.
19.1	Pass small stony knoll on L.H.S.
19.4	between small knoll on L.H.S. and large knoll on R.H.S.
19.8	Pass knoll on L.H.S.
20.3	Between 2 large knolls veer RIGHT off track.
	Bottom of trig. 5 min. walk in northerly direction
* 10.4	Take track on R.H.S.
15.1	Turn LEFT at 'T' intersection.
17.4	Thru gate
19.6	Turn LEFT off track (see 19.8 on 1st access)
20.1	Bottom of trig. 5 min walk in northerly direction.

Date	Record of Station

<p>Not to Scale</p>	<p>This section to be completed by officer constructing pillar.</p> <p>Original station mark found/not found.</p> <p>Description of mark: .....</p> <p>Original beacon found/not found.</p> <p>Description of beacon: .....</p> <p>Height Top of Vanes to Top Mark .....m.</p> <p>Height of mark .....m. above G.L. below</p> <p>Diameter of Vanes .....m. Height of Cairn .....m.</p> <p>Original Beacon has/has not been destroyed by me.</p>
---------------------	---