

GEODEIC SURVEY OF N.S.W.

CENTRAL MAPPING AUTHORITY

GEODEIC STATION RECONNAISSANCE and MAINTENANCE REPORT

Description:

Note: Cross out word or words which do not apply

1. Cleared by lenses bearings: ~~.....~~ Cleared ~~.....~~ 360° ~~.....~~ from Trig, Mast
2. Mast & Vanes: ~~needed~~ painting white & black respectively.
3. The station pillar was supplied/not unpiled/~~constructed on~~ ~~.....~~ 40° ~~.....~~ dimensions ~~new being~~
- Description of mark: ~~.....~~ should be explicit, e.g., S/Steel Pillar Plate, Steel plug, Brass plug, Bolt, G.I. Pipe
- Height of mark: ~~.....~~ m. ~~above~~ rock/concrete; Mark is ~~.....~~ m. ~~above~~ G.L.
- Height of Top Vanes to Top Mark/Pillar plate ~~.....~~ m. Diameter of Vanes (vertical) ~~.....~~ m.
- Height of Cairn ~~.....~~ m. Diameter of Cairn ~~.....~~ m. Name Plate found/not found/Alaced.
- Length of Mast ~~.....~~ m. (approximate if not unpiled)
4. A ~~.....~~ ^{S.S.M} set in conc/rock has been placed/found, bearing ~~.....~~ 254° 0' M from Mas. Plug/Pillar ~~not searched~~
5. A ~~.....~~ ^{GIP} set in conc/rock has been p. ced/found, bearing ~~.....~~ 172° 0' M from Mast/Ply/Pillar } for
6. A ~~.....~~ set in conc/rock has been placed/found, bearing ~~.....~~ 0° M from Mast/Plug/Pillar
7. A ~~.....~~ set in conc/rock has been placed/found, bearing ~~.....~~ 0° M from Mast/Plug/Pillar
8. Action required: ~~.....~~ ^{Paint} ~~.....~~ ^{name plate} ~~.....~~

STANDPOINT:

Mark	Direction	Horiz. Distance	Height Difference	Mark	Direction	Horiz. Distance	Height Difference
			above standpt.				above standpt.
			below				below standpt.
			above standpt.				above standpt.
			below				below standpt.
Prepared by: Mulla 4-1-18 17-10-18

Checked: WJ 23/1/17 Noted on U.T.M. Card

S: 2733-1

STATION: NIGHTCAP G.S. TS No.: 3377

MAP SHEET SCALE 1:250 000 GRAFTON

INSPECTED BY: N. KRAHE DATE: 7-9-18

AUTHORITY: C. M. A. FIELD BOOK: -

Station Diagram

Not to Scale

GEODETTIC SURVEY OF N.S.W.

CENTRAL MAPPING AUTHORITY

GEODETTIC STATION RECONNAISSANCE and MAINTENANCE REPORT

Description:

1. Cleared by lanes bearing..... *See sketch*..... from Trig. Mast
 Note: Cross out word or words which do not apply

2. Mast & Vanes have been painted white & black respectively.

3. The station/pillar was ~~supplied~~/not supplied/~~constructed~~ on..... *19.7.79*....., dimensions now being:

Description of mark..... should be explicit, e.g., S/Steel Pillar Plate, Steel plug, Brass plug, Bolt, G.I. Pipe

Height of mark.....m. ^{above} rock/concrete; Mark is.....m. ^{above} below G.L.

Height of Top Vanes to Top Mark/Pillar plate.....m. Diameter of Vanes (vertical).....m.

Height of Cairn.....m. Diameter of Cairn.....m. Name Plate found/not found/placed.

Length of Mast.....m. (approximate if not unripled)

4. A..... *S.S.M.*..... set in ~~conc~~/rock has been ~~placed~~/found, bearing.....°M from Mast/~~Plug/Pillar~~ *Reliable*

5. A..... *G.I. Pipe* set in ~~conc~~ has been ~~placed~~/found, bearing.....°M from Mast/~~Plug/Pillar~~

6. A..... set in conc/rock has been placed/found, bearing.....°M from Mast/Plug/Pillar

7. A..... set in conc/rock has been placed/found, bearing.....°M from Mast/Plug/Pillar

8. Action required: *Paint mast & G.I. vanes holding it up*

Trigs Sighted	Grid Approx	Horiz. Distance	Height Difference	Hills Sighted	Grid Approx	Horiz. Distance	Height Difference
Bald Nob	5	9	above standpt.	Broadmeadows	75	55	above standpt.
Kinggate	33	14	above standpt.	Thebras	160	29	below standpt.
Paddy Valley	19	13	above standpt.	Rumbee	274	35	above standpt.
Sand	249	8	below				below
Whitchell	249	15	above standpt.				above standpt.
Blair Hill	334	5	below				below
Mosquito	244	42	above standpt.				above standpt.
Key	357	34	below				below
Tin Mine	357	34	above standpt.				above standpt.
Skeleton	256	31	below				below

Prepared by: *J. Fanning*

Checked: *J. Fanning* 1979/79

Noted on U.T.M. Card

ST 2733-1

STATION: *NIGHTCAP G.S.* No.: *3377*
 MAP SHEET SCALE 1:250 000 *GRAFTON*
 INSPECTED BY: *J. FANNING* DATE: *14th May 79*
 AUTHORITY: *C.M.A.* FIELD BOOK: *1753*

Station Diagram

Checked

SI 2753-2 D. West, Government Printer

STATION NIGHTCAP G.S. TS 3377	Owner's Name: <i>Forestry Commission</i> Address: <i>Glen Innes District</i> <i>Marie State Forest</i> Phone:	Current Occupant: <i>Permissions obtained</i> Address: <i>Mr V EBY</i> <i>(District Forester)</i> Phone:	ACCESS 14-5-1979 AWD	Access Report of <i>18/6/1964</i> was found unsuitable suitable. <i>7/9/1979 was updated</i> kms 0.75D Corner Oliver St & New England N-way Glen Innes. Travel towards PINKETT . 17.46 Pass PINKETT Auto Tele Shack L.H.S. 38.47 Pass track L.H.S. Sign "London Bridge Fire Trail" 42.66 Turn right off road through wire gate follow track 43.61 Gate 44.08 Pass shed L.H.S. 44.35 Gate (S. west corner of paddock) 45.18 Through fence take left track 45.71 Cross Top of L.S.I 46.41 Cross watercourse take left track beside washway 48.31 Wire gate 49.66 Cross watercourse & swampy area follow around north side of swamp 48.82 Blazed tree follow blazed trail 49.08 Park Truck 40 minute walk to Trig with NO LOAD track to Trig is only blazed for returning to Truck
Beacon Diagram Not to Scale	This section to be completed by officer constructing pillar. Original station mark found/not found. Description of mark: Original beacon found/not found. Description of beacon: Height Top of Vanes to Top Markm. Height of mark:m. above rock/concm. below G.L. Diameter of Vanesm. Height of Cairnm. Original Beacon has/has not been destroyed by me.			
Date		Record of Station		

GEODETTIC SURVEY OF NSWK

CENTRAL MAPPING AUTHORITY

GEODETTIC STATION RECONNAISSANCE and MAINTENANCE REPORT

- Description: 340° Note: Cross out word or words which do not apply
- Cleared by lanes bearing 340° from Trig. Mast
 - Mast & Vanes have been painted white & black respectively. ✓
 - The station/pillar was unpiled/~~not supplied~~/constructed on 1915, dimensions now being: 1915, 1915, dimensions now being: 1915, 1915
 - Description of mark 1915 should be explicit, e.g., S/Steel Pillar Plate, Steel plug, Brass plug, Bolt, G.I. Pipe
 - Height of mark 0.25 m. ^{above} rock/concrete Mark is 1915 m. ^{above} G.L. Diameter of Vanes (vertical) 1.15 m.
 - Height of Top Vanes to Top Mark/Pillar-plate 3.325 m.
 - Height of Cairn 1.00 m. Diameter of Cairn 1.00 m. Name Plate found/~~not found~~/placed. ✓
 - Length of Mast 3.350 m. (approximate if not unpiled)
 - A 3.350 m. set in conc/rock has been placed/found, bearing 257° M from Mast/Plug/Pillar
 - A 6.185 m. set in conc/rock has been placed/found, bearing 188° M from Mast/Plug/Pillar
 - A m. set in conc/rock has been placed/found, bearing ° M from Mast/Plug/Pillar
 - A m. set in conc/rock has been placed/found, bearing ° M from Mast/Plug/Pillar
- Action required:

STANDPOINT: <u>Brass Trig Pole</u>		STANDPOINT: <u>C.S.M.</u>				
Mark	Direction	Horiz. Distance	Height Difference	Direction	Horiz. Distance	Height Difference
<u>Mast/Plate</u>	<u>0 00 00</u>	<u> </u>	<u> </u>	<u>0 00 00</u>	<u> </u>	<u> </u>
<u>S.S.M</u>	<u>14 13 40</u>	<u>2.604</u>	<u>190</u>	<u>14 13 40</u>	<u>2.599</u>	<u>185</u>
<u>Uroslavuds G.S.</u>	<u>255 01 45</u>	<u> </u>	<u> </u>	<u>244 20 49</u>	<u>3.454</u>	<u>357</u>
<u>Cairn</u>	<u>217 26 00</u>	<u>2.614</u>	<u>546</u>	<u>235 01 36</u>	<u> </u>	<u> </u>

Prepared by: Checked: Noted on U.T.M. Card

SR 2723-1

STATION: Mast/Plate G.S. No.: 3377

MAP SHEET SCALE 1:250 000

INSPECTED BY: L.L. HOLLIS DATE: 14/11/24


AUTHORITY: C.M.A. FIELD BOOK: 1671

Station Diagram

North

Not to Scale

8: 2733-2 D. West, Government Printer	Beacon Diagram	Not to Scale	STATION <i>Natural LS TS 3377</i>	Owner's Name: Address: Phone: Current Occupant: Address: Phone: ACCESS Access Report of/...../19.....was found suitable/unsuitable.	Record of Station
This section to be completed by officer constructing pillar: Original station mark found/not found. Description of mark: <i>SARK ABOVE</i> Original beacon found/not found. Description of beacon: Height Top of Vanes to Top Mark m. Height of mark m. above G.L. / below G.L. Diameter of Vanes m. Height of Cairn m. Original Beacon has/has not been destroyed by me.			Date		

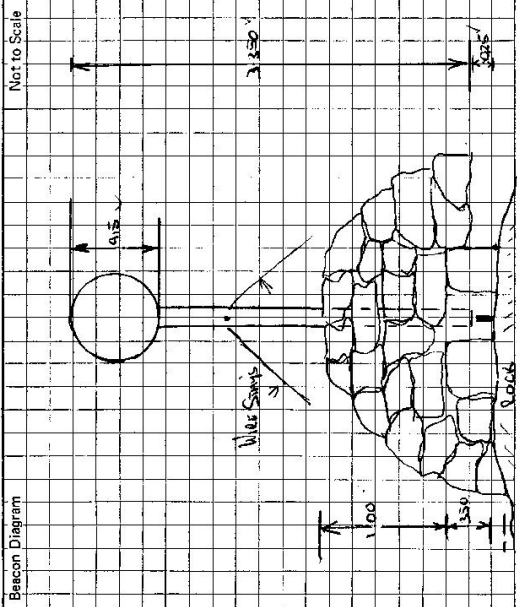

Date	Record of Station