

SI 2733--2 D. West, Government Printer

Beacon Diagram	Not to Scale	STATION NIGHTCAP TS 3378
<p>This section to be completed by officer constructing pillar.</p> <p>Original station mark found/not found.</p> <p>Description of mark:</p> <p>Original beacon found/not found.</p> <p>Description of beacon:</p> <p>Height Top of Vanes to Top Mark.....m.</p> <p>Height of mark.....m. above G.L. below</p> <p>Diameter of Vanesm. Height of Cairnm.</p> <p>Original Beacon has/has not been destroyed by me.</p>	<p>Owner's Name: Mr. Hill</p> <p>Address:</p> <p>Phone:</p> <p>Current Occupant:</p> <p>Address:</p> <p>Phone:</p> <p style="text-align: center;">ACCESS</p> <p>Access Report of 1/10/14 was found suitable/unsuitable. Oibenville P.O, turn right Stephen street Sign reads Beauty Creek Mill on right 10-0 Turn right 11-2 Beauty creek bridge 12-3 Boundary creek bridge 13-0 Beauty Creek Plantation Forest Road on right 13-5 Turn right 13-8 Wiregate to stock yards 21-0 House; see owner 21-5 Wooden gate 21-65 .. 21-8 Creek crossing 23-6 Wire Gate 23-95 Turn left at Fork. Blaze on tree. Follow track up ridge drive straight on where track turns left down hill at 23-1 km</p> <p>Follow faint track up rocky face pick even way or crisscross with blazes. Walk around left side of large rock. Faint track to Δ About 40 mins walk without load.</p>	<p>Date</p> <p>Record of Station</p>

GEODETIC SURVEY OF A.S.W.

CENTRAL MAPPING AUTHORITY

GEODETIC STATION RECONNAISSANCE and MAINTENANCE REPORT

Description:

- Cleared by lanes bearing Timbered 36.0° from Trig. Mast
Note: Cross out word or words which do not apply
- Mast & Vanes have been painted white & black respectively, NO BEACON Small Cairn found
- The station/pillar was unpiled/net-unpiled/constructed on 19, dimensions now being: (not searched)
 Description of mark Cartilage Case (not searched) should be explicit, e.g., S/Steel Pillar Plate, Steel plug, Brass plug, Bolt, G.I. Pipe
 Height of mark 0.0 m. above reef/concrete; Mark is m. above G.L.
 Height of Top Vanes to Top Mark/Pillar plate m. Diameter of Vanes (vertical) m.
 Height of Cairn 0.4 m. Diameter of Cairn 1.5 m. Name Plate found/not found/placed.
 Length of Mast m. (approximate if not unpiled)
- A set in conc/rock has been placed/found, bearing ° M from Mast/Plug/Pillar
- A pegs set in conc/rock has been placed/found, bearing ° M from Mast/Plug/Pillar
- A pegs set in conc/rock has been placed/found, bearing ° M from Mast/Plug/Pillar
- A set in conc/rock has been placed/found, bearing ° M from Mast/Plug/Pillar
- Action required: Clearing 1-2 days (light chainsaw & axe) / New mast & vanes / Place witness marks

STANDPOINT:

Mark	Direction	Horiz. Distance	Height Difference	Mark	Direction	Horiz. Distance	Height Difference
EDM	* Hill		above standpt.	GLENNIES CHAIR	* Hill		above standpt.
EDM	* Hill		below standpt.	GILLIES (GOLD)	* Hill		above standpt.
EDM	* Hill		below standpt.	CLUNIE	* Hill		below standpt.
EDM	M&V		above standpt.	TOOLOOM	M&V		above standpt.
EDM	M&V		below standpt.	DOMA	Hill (No beacon)		below standpt.
VA	* Clearing		above standpt.	ATH OBELISK	Clearing		above standpt.
VA	* Clearing		below standpt.	PEACOCK	Clearing		below standpt.
VA	* Clearing		above standpt.				above standpt.
VA	* Clearing		below standpt.				below standpt.
VA	* Clearing		above standpt.				above standpt.
VA	* Clearing		below standpt.				below standpt.
VA	* Clearing		above standpt.				above standpt.
VA	* Clearing		below standpt.</				

STATION MILK CREEK C.S. TS 3378

Owner's Name: MR. GARDIAN, LEED

Address: WARRAWARRA, WARRAWARRA, SA

Phone: 3213241

Current Occupant:

Address:

Phone:

ACCESS

Access Report of 12/10/1988 was found suitable/unsuitable.

Feature

0700 URBANVILLE P.O. HEARD SIGN TOWARDS TOWNFIELD ✓

0715 TOWN QUART INTO BENCH ST ✓

0745 TOWN QUART AT T-INTERSECTION LEAVING L.A. ✓

0730 MISS BENCHY PUNATIONAL FOREST RD, ON LEFT ✓

0750 TOWN QUART ✓

0800 TOWNQUART INTO GATE WERE D.P. WARD ON CORNER BENCH ✓

1030 CUMMINS HOUSE MA. BILL WARD DRESSING LEAVE HERE ✓

1032 TOWN QUART ON CORNER WARD SIGN WARD BENCH SUBMIT LEFT ✓

1040 GATE. THREE DOWN TO RIGHT ✓

1045 GARDEN COURSEING ✓

1100 WARD GATE (MURKIN DOWN) ✓

1150 TOWN QUART LEFT AND ALONG ROAD RUMBLE TREE ✓

1110 LEAVE VEHICLE AT ROAD'S ✓

1115 FROM HERE WALK UP AND ABOUT 12 L.I.S. OF ROAD ✓

AND REMAIN TOP OF ROAD TO TOP ✓


30 MINUTE EXERCISE EASER WALK ✓

Not to Scale

Beacon Diagram

New Mass and Vanes

View Picked

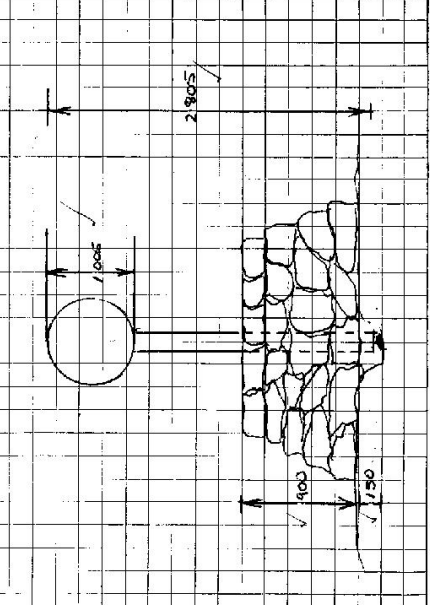

This section to be completed by officer constructing pillar.

Original station mark found/not found. ✓

Description of mark: WARRAWARRA SUBURBAN CORNER, WARRAWARRA, SA

Original beacon found/not found. ✓

Description of beacon: CHINA PILE & DISC

Height Top of Vanes to Top Mark m.

Height of mark m. above below G.L.

Diameter of Vanes m. Height of Cairn m.

Original Beacon has been destroyed by fire.

Date

Record of Station