


SI: 2733-2 D. West, Government Printer

STATION **NIMMO** **TS 3383**

Owner's Name:
 Address:
 Phone:
 Current Occupant:
 Address:
 Phone:

ACCESS
 Access Report of 15.4.1980, was found suitable/unsuitable.
 From Jimabyme P.O. travel towards Cooma. Take road to Eucumbene Dam. Turn left on dirt road 3 kms past the Rocky Plains property, and just after transmission lines. Cross the Eucumbene River. 1 km further on take left turn. Follow track until you meet transmission line. With transmission lines running alongside, follow track. Take track to right at transmission pylon MC75. Go for 200 metres along track to clearing on right. Follow clearing away from track for a 400 metres. Trig is at right at 10-20 metres from clearing in trees.

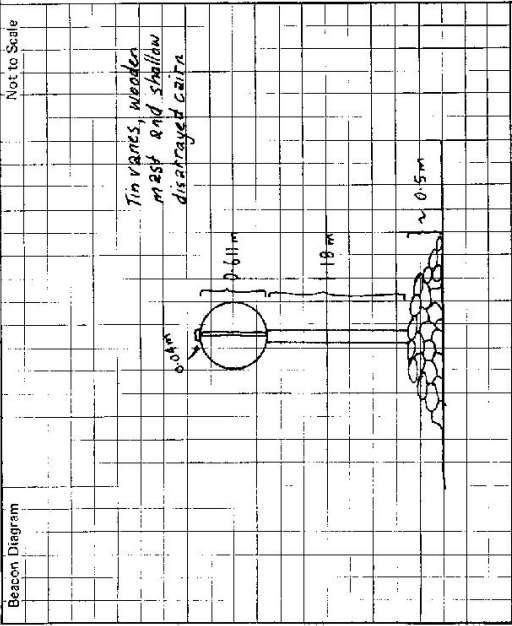

This section to be completed by officer constructing pillar.

Original station mark found/not found.
 Description of mark:
 Original beacon found/not found.
 Description of beacon:
 Height Top of Vanes to Top Markm.
 Height of markm. above G.L. below
 Diameter of Vanesm. Height of Cairnm.
 Original Beacon has/has not been destroyed by me.

Date	Record of Station