


CENTRAL MAPPING AUTHORITY

STATION: NM/B/147 No: 3410

MAP SHEET SCALE 1:250 000 ANGLEDDDL

INSPECTED BY: D. FREDRIKSEN DATE: 31/7/79

AUTHORITY: C. M. A. FIELD BOOK: 1572

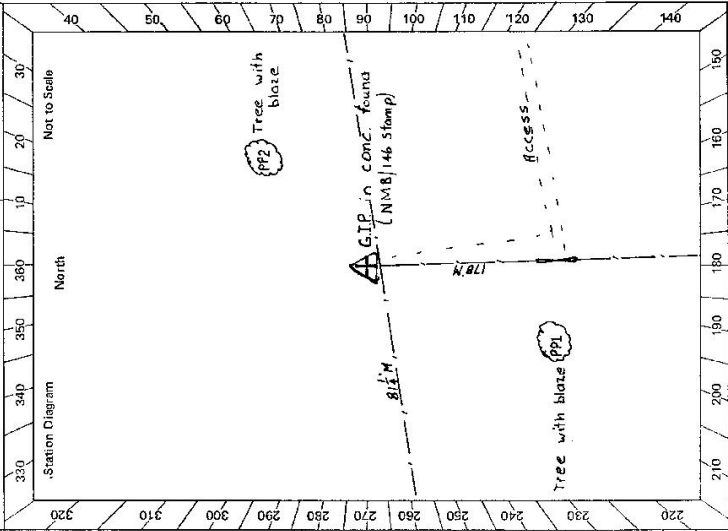

GEODETIC STATION RECONNAISSANCE and MAINTENANCE REPORT

- Description: *Note: Cross out word or words which do not apply*
1. Cleared by lanes bearing..... from Trig. Mast
  2. Mast & Vanes have been painted white & black respectively.
  3. The station/pillar was unpiled/not unpiled/constructed on..... 19....., dimensions now being:  
Description of mark G.I.P. in conc. should be explicit. e.g., S/Steel Pillar Plate, Steel plug, Brass plug, Bolt, G.I. Pipe  
Height of mark.....m. above below rock/concrete; Mark is.....m. above below G.I.L.  
Height of Top Vanes to Top Mark/Pillar plate.....m. Diameter of Vanes (vertical).....m.  
Height of Cairn.....m. Diameter of Cairn.....m. Name Plate found/not found/placed.  
Length of Mast.....m. (approximate if not unpiled)
  4. A.....set in conc/rock has been placed/found, bearing.....°M from Mast/Plug/Pillar
  5. A.....set in conc/rock has been placed/found, bearing.....°M from Mast/Plug/Pillar
  6. A.....set in conc/rock has been placed/found, bearing.....°M from Mast/Plug/Pillar
  7. A.....set in conc/rock has been placed/found, bearing.....°M from Mast/Plug/Pillar
  8. Action required:.....

STANDPOINT: G.I.P. in conc. (A)							
Mark	Direction	Horiz. Distance	Height Difference	Mark	Direction	Horiz. Distance	Height Difference
Fence Intersection	178° Mag	0.7m	above standpt				above standpt
8m High			below				below
PPI Tree 7m Cover	191.4° "	81.9	above standpt				above standpt
6m High			below				below
PPI Tree 5m Cover	45.3° "	59.5	above standpt				above standpt
			below				below
			above standpt				above standpt
			below				below
			above standpt				above standpt
			below				below

Prepared by: D. Fredriksen  
Checked: [Signature] 27/7/79 Noted on U.T.M. Card

84 2733—2 D. West, Government Printer

STATION NM/147 TS 3410

Beacon Diagram	Not to Scale	
<div style="border: 1px solid black; padding: 5px;"> <p><b>Owner's Name:</b> .....</p> <p><b>Address:</b> .....</p> <p><b>Phone:</b> .....</p> <p><b>Current Occupant:</b> .....</p> <p><b>Address:</b> .....</p> <p><b>Phone:</b> .....</p> <p><b>ACCESS</b></p> <p>Access Report of 27.7.1977 was found <del>unsuitable</del> suitable.</p> <p><b>FEATURE</b></p> <p>Just NORTH of NSW-QLD. border head west</p> <p>To Birranbandi 50km.</p> <p>New Angledool 20 km.</p> <p>Collarenebri 65 km.</p> <p>1-0 Thro' gate in N-S fence</p> <p>1-5 Thro' Gate with fence on R.H.S.</p> <p>2-2 Thro' gate</p> <p>3-8 Pass Gate on R.H.S. in E-W fence</p> <p>4-5 Thro' Gate in N-S fence</p> <p>5-7 At NM/147 see sketch.</p> </div>		<p style="text-align: center;">NM/147 was pinned on C.M.A. photo NSW 2718/117</p> <p style="text-align: center;">" " " " R.A.S.C. " NSW 2718/118</p>
<p>This section to be completed by officer constructing pillar.</p> <p>Original station mark found/not found.</p> <p>Description of mark: .....</p> <p>Original beacon found/not found.</p> <p>Description of beacon: .....</p> <p>Height Top of Vanes to Top Mark .....m.</p> <p>Height of mark .....m. above G.L. rock/cons .....m. below</p> <p>Diameter of Vanes .....m. Height of Cairn .....m.</p> <p>Original Beacon has/has not been destroyed by me.</p>		
		Date
		Record of Station

**LAND INFORMATION CENTRE**

GEODETIC SURVEY OF A.S.W.

**GEODETIC STATION RECONNAISSANCE and MAINTENANCE REPORT**

**Description:**

1. Cleared by vanes bearing..... *Note: Cross out word or words which do not apply*  
 from Trig. Mast

2. Mast & Vanes have been painted white & black respectively.

3. The station/pillar was unpiled/not unpiled/constructed on..... 19....., dimensions now being:

Description of mark..... should be explicit, e.g., S/Steel Pillar Plate, Steel plug, Brass plug, Bolt, G.I. Pipe

Height of mark.....m. <sup>above</sup> rock/concrete; Mark is.....m. <sup>above</sup> G.L. <sub>below</sub>

Height of Top Vanes to Top Mark/Pillar plate .....m. Diameter of Vanes (vertical).....m.

Height of Cairn.....m. Diameter of Cairn.....m. Name Plate found/not found/placed.

Length of Mast .....m. (approximate if not unpiled)

4. A..... set in conc/rock has been placed/found, bearing.....° M from Mast/Plug/Pillar

5. A..... set in conc/rock has been placed/found, bearing.....° M from Mast/Plug/Pillar

6. A..... set in conc/rock has been placed/found, bearing.....° M from Mast/Plug/Pillar

7. A..... set in conc/rock has been placed/found, bearing.....° M from Mast/Plug/Pillar

8. Action required:.....

**STANDPOINT:**

Mark	Direction	Horiz. Distance	Height Difference	Mark	Direction	Horiz. Distance	Height Difference
			above standpt.				above standpt.
			below				below
			above standpt.				above standpt.
			below				below
Prepared by: *By Ford* 10/4/91

Checked: *L.C. 2/5/91*

Noted on U.T.M. Card

STATION: *NMB 147* TS No.: *3410*

MAP SHEET SCALE: *1:100,000*

INSPECTED BY: *G. FORD* DATE: *MARCH 1991*

AUTHORITY: *L.I.C.* FIELD BOOK: *-*

Not to Scale

Checked

STATION **NMB 147 TS 3410**

Owner's Name: .....  
 Address: .....  
 Phone: .....  
 Current Occupant: .....  
 Address: .....  
 Phone: .....

**March 1991**

Access Report of ...../...../19..... was found suitable/unsuitable.


NMB 147

DUNMURRAL 1:100 000

- 0.00 *Sunambandi / Callanabai Road NSW QLD Border*
- 3.26 *led sent (Glenelough gate)*
- 4.27 *Turn left along track opposite Access to "Boombini"*
- 6.8 *Swirl Iron gate*
- 7.29 *Iron gate*
- 9.13 *Swirl - windmill on left*
- 9.41 *Turn right 40-metre before gate*
- 9.54 *Swirl - windmill on left*
- 9.63 *Take left hand (chain crossing)*
- 10.23 *Cross chain catch yard on left*
- 10.29 *Swirl iron gate*
- 11.47 *Through gate to QLD side at left along fence*

*The mud slugs have the hill!*  
*Mud in mouth NMB 146 (see original report)*

*All clear for G.P.S.*

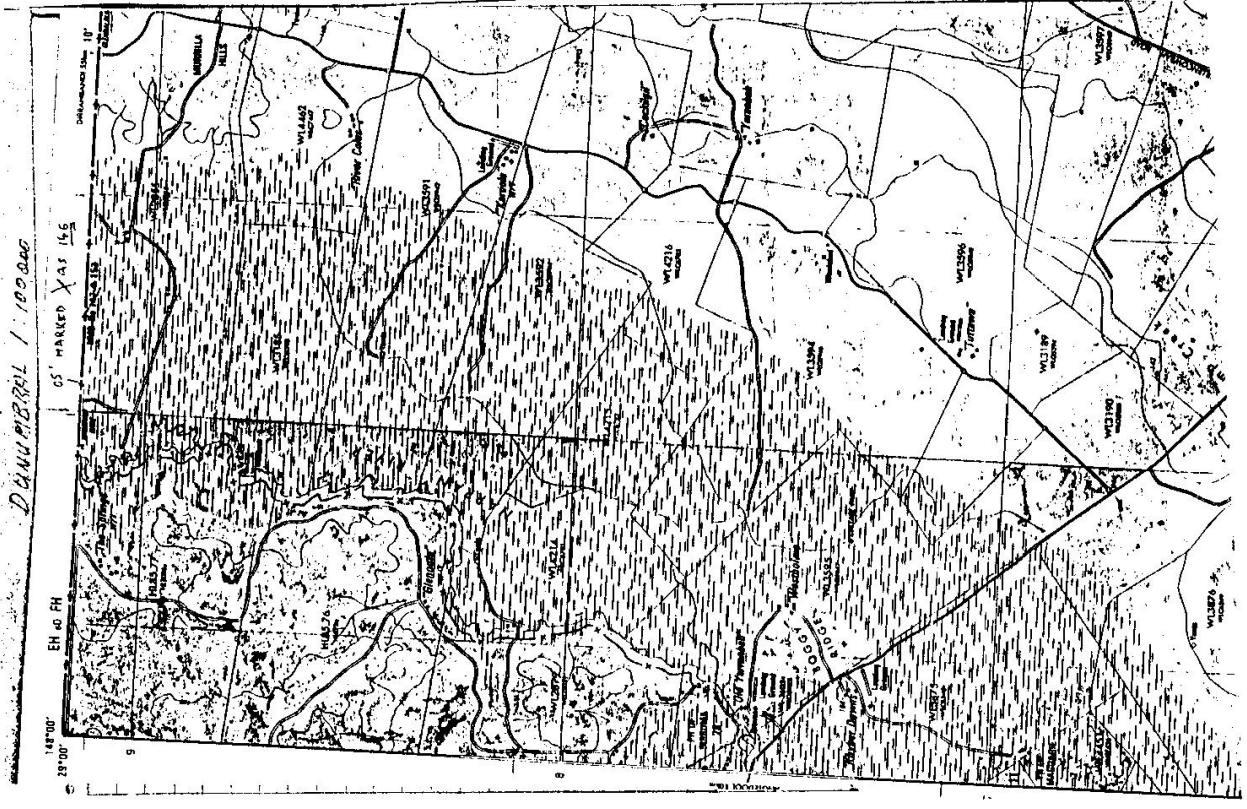

Date

CARD 1 of 2 CARDS

BATCH 1497

GEODETTIC SURVEY OF ALSIA

CENTRAL MAPPING AUTHORITY

GEODETTIC STATION RECONNAISSANCE and MAINTENANCE REPORT


STATION: NM B 147 No.: 3410

MAP SHEETS SCALE 1:250 000 ANGLEDOOL DONUMBRAL

INSPECTED BY: J SUTTON DATE: 24th April, 1991

AUTHORITY: L.I.C. FIELD BOOK: 1974

SCALE 1:100 000

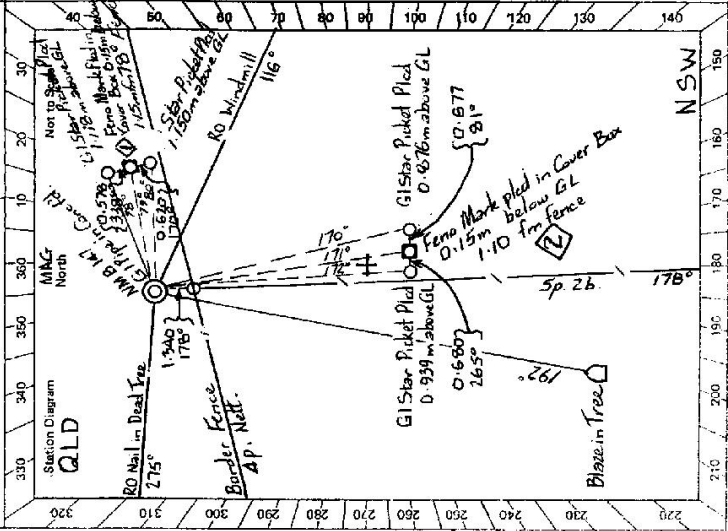

Description: Note: Cross out word or words which do not apply

1. Cleared by lanes bearing: from Trig. Mast

2. Mast & Vanes have been painted white & black respectively

3. The station/pillar was unplied/ret-empted/constructed on: 24th April, 1991, dimensions now being: Magg 10°

Description of mark: G1 Pipe in Conc. fd

Height of mark: above lock/concrete; Mark is: above G.L.

Height of Top Vanes to Top Mark/Pillar plate: Diameter of Vanes (vertical):

Height of Cairn: Diameter of Cairn: Name Plate found/lost found/lost:

Length of Mast: (approximate if not unplied)

4. A G1 Star Picket set in concrete has been placed/removed, bearing: °M from Mast/Plug/Pillar G1 P. pz. fd

5. A Feno Mark in Conc. fd set in concrete has been placed/removed, bearing: °M from Mast/Plug/Pillar G1 P. pz. fd

6. A Star Picket set in concrete has been placed/removed, bearing: °M from Mast/Plug/Pillar G1 P. pz. fd

7. A G1 Star Picket set in concrete has been placed/removed, bearing: °M from Mast/Plug/Pillar G1 P. pz. fd

8. Action required: Azimuth OBS & check AD's & SH & marks

STANDPOINT: NMB 147 G1 Pipe in Conc. fd. STANDPOINT: Feno Mark Placed in Cover Box RM

Mark	Direction	Horiz. Distance	Height Difference	Mark	Direction	Horiz. Distance	Height Difference
RO Nail in Dead Tree	0° 00' 00"	16.544	above standard	RO Nail in Dead Tree	0° 00' 00"	16.544	above standard
G1 Star Picket Plad RM	69° 29' 43"	16.544	below	G1 Star Picket Plad RM	69° 29' 43"	16.544	below
Feno Mark Plad RM	62° 09' 08"	16.544	below	RO Windmill	202° 48' 57"	16.544	below
Star Picket Plad RM	64° 09' 08"	16.544	above	Star Picket Plad RM	258° 07' 35"	16.544	above
RO Windmill	200° 13' 52"	16.544	above	G1 Star Picket Plad RM	300° 52' 39"	23.086	above
G1 Star Picket Plad RM	253° 14' 17"	16.544	below	Feno Mark Plad RM	302° 01' 55"	23.086	below
Feno Mark Plad RM	255° 42' 02"	16.544	below	G1 Star Picket Plad RM	303° 18' 32"	24.019	below
G1 Star Picket Plad RM	258° 08' 16"	16.544	below	NMB 147 G1 P. fd	348° 48' 34"	16.613	above standard

Prepared by: J Sutton Checked: 28.4.91

Noted on U.T.M. Card

Checked: 29.9.91

407

912735-2 D. West Government Printer

Beacon Diagram

Not to Scale

Note: The concrete collar for this mark was incorrectly labelled as NM B 146. I have chiselled NM B 147 into this concrete collar to correct this anomaly.

Owner's Name: .....  
 Address: .....  
 Phone: .....  
 Current Occupant: .....  
 Address: .....  
 Phone: .....

STATION NM B 147 TS 3410

ACCESS 24-4-1991

Access Report of: ..... was found ~~unsuitable~~ <sup>unsuitable</sup>.

- Kms
- 0:00 On Dimambendi-Collarenebri Road at Glendalough Gate (NSW/QLD Border) head South.
  - 3:26 Turn right along track opposite access to "Boorumbirra".
  - 4:27 Through double iron gate.
  - 6:08 Through iron gate (Windmill on left)
  - 7:29 Through iron gate.
  - 9:13 Turn right onto track 40m before iron gate.
  - 9:41 Dam and wind mill on left.
  - 9:54 Take left fork at drain crossing.
  - 9:63 Cross drain (Cattle yard on left).
  - 10:23 Through double iron gates.
  - 10:29 Through gates onto Queensland side. Turn left along fence line.
  - 11:47 NMB 147

Dry Weather Access ONLY

This section to be completed by officer constructing pillar.

Original station mark found/not found.

Description of mark: .....

Original beacon found/not found.

Description of beacon: .....

Height Top of Vanes to Top Mark .....m.

Height of mark .....m. above G.L. below

Diameter of Vanes .....m. Height of Cairn .....m.

Original Beacon has/not been destroyed by me.

Date

Record of Station

CARD 2 of 2 CARDS

GEODETTIC SURVEY OF N.S.W.

CENTRAL MAPPING AUTHORITY

GEODETTIC STATION RECONNAISSANCE and MAINTENANCE REPORT

STATION: **NM B 147** No.: **3410**

MAP SHEETS: **ANGLEPOOL** SCALE 1:100 000

INSPECTED BY: **J. SUTTON** DATE: **24th Apr. 1991**

AUTHORITY: **L.I.C.** FIELD BOOK: **1974**

Description: *Note: Cross out word or words which do not apply*

1. Cleared by lanes bearing..... from Trig. Mast

2. Mast & Vanes have been painted white & black respectively.

3. The station/pillar was unpiled/not unpiled/constructed on..... 19....., dimensions now being:

Description of mark..... should be explicit, e.g., S/Steel Pillar Plate, Steel Plug, Brass plug, Bolt, G.I. Pipe

Height of mark..... m. above rock/concrete; Mark is..... m. above G.L.

Height of Top Vanes to Top Mark/Pillar plate..... m. Diameter of Vanes (vertical)..... m.

Height of Cairn..... m. Diameter of Cairn..... m. Name Plate found/not found/placed.

Length of Mast..... m. (approximate if not unpiled)

4. A. ~~Ferro Mark in Cover~~ <sup>Soil</sup> ~~set in concrete~~ has been placed/~~found~~, bearing..... °M from ~~Mast/Plug/Pillar~~ G.I. Pipe

5. A. ~~G.I. Star~~ <sup>Soil</sup> ~~Picket~~ has been placed/~~found~~, bearing..... °M from ~~Mast/Plug/Pillar~~ G.I. Pipe

6. A..... set in conc./rock has been placed/~~found~~, bearing..... °M from Mast/Plug/Pillar

7. A..... set in conc./rock has been placed/~~found~~, bearing..... °M from Mast/Plug/Pillar

8. Action required:.....

STANDPOINT: **Ferro Mark Piled in Cover Box RMS** ② STANDPOINT:

Mark	Direction	Horiz. Distance	Height Difference	Mark	Direction	Horiz. Distance	Height Difference
NO NAIL in Dead Tree	0° 00' 00"	15.717	0.214				
NM B 147 GIP G.I.	70° 22' 59" B	15.717	0.214				
G.I. Star Picket Piled RM	113° 49' 56"	23.953					
Ferro Mark Piled RM	115° 03' 29" 2	23.583	0.006				
Star Picket Piled RM	116° 02' 17" 5	23.136					
RM Winderon II	194° 22' 43" 8						
G.I. Star Picket Piled RM	199° 22' 24" 4						
G.I. Star Picket Piled RM	344° 22' 13" 3						

Prepared by: *[Signature]* 28.4.91 Checked: *[Signature]* 28.4.91

Noted on U.T.M. Cards

Checked

