

LAND INFORMATION CENTRE

GEODETIC SURVEY OF N.S.W. **Bald 1504**

GEODETIC STATION RECONNAISSANCE and MAINTENANCE REPORT

Description:

1. Cleared by lanes bearing..... *Note: Cross out word or words which do not apply*
2. Mast & Vanes have been painted white & black respectively. from Trig, Mast
3. The station/pillar was unpiled/not unpiled/constructed on..... 19....., dimensions now being:
- Description of mark..... *Star Picket in conc* should be explicit, e.g., S/Steel Pillar Plate, Steel plug, Brass plug, Bolt, G.I. Pipe
- Height of mark.....m. ^{above} rock/concrete; Mark is.....m. ^{above} G.L. _{below}
- Height of Top Vanes to Top Mark/Pillar platem. Diameter of Vanes (vertical).....m.
- Height of Cairn.....m. Diameter of Cairn.....m. Name Plate found/not found/placed.
- Length of Mast.....m. (approximate if not unpiled)
4. A. *STAR PICKET*.....set in conc/~~rock~~ has been *placed*/found; bearing.....°M from Mast/Plug/Pillar
5. A.....set in conc/rock has been placed/found; bearing.....°M from Mast/Plug/Pillar
6. A.....set in conc/rock has been placed/found; bearing.....°M from Mast/Plug/Pillar
7. A.....set in conc/rock has been placed/found; bearing.....°M from Mast/Plug/Pillar
8. Action required:.....

STANDPOINT: *STAR PICKET IN CONC FOL* (NMC 116) STANDPOINT:


| Mark | Direction | Horiz. Distance | Height Difference | Mark | Direction | Horiz. Distance | Height Difference |
|-----------------------|-----------|-----------------|-------------------|------|-----------|-----------------|-------------------|
| NMC 118 | 0 00 00 | | above below | | | | above below |
| <i>Barren Ridge</i> 5 | 232 20 05 | | above below | | | | above below |
| STAR PICKET FOL | 55 38 40 | 3.967 0.012 | above below | | | | above below |
| | | | above below | | | | above below |
| | | | above below | | | | above below |
Prepared by:

Checked:

Noted on U.T.I.L. Card

S: 2733-1

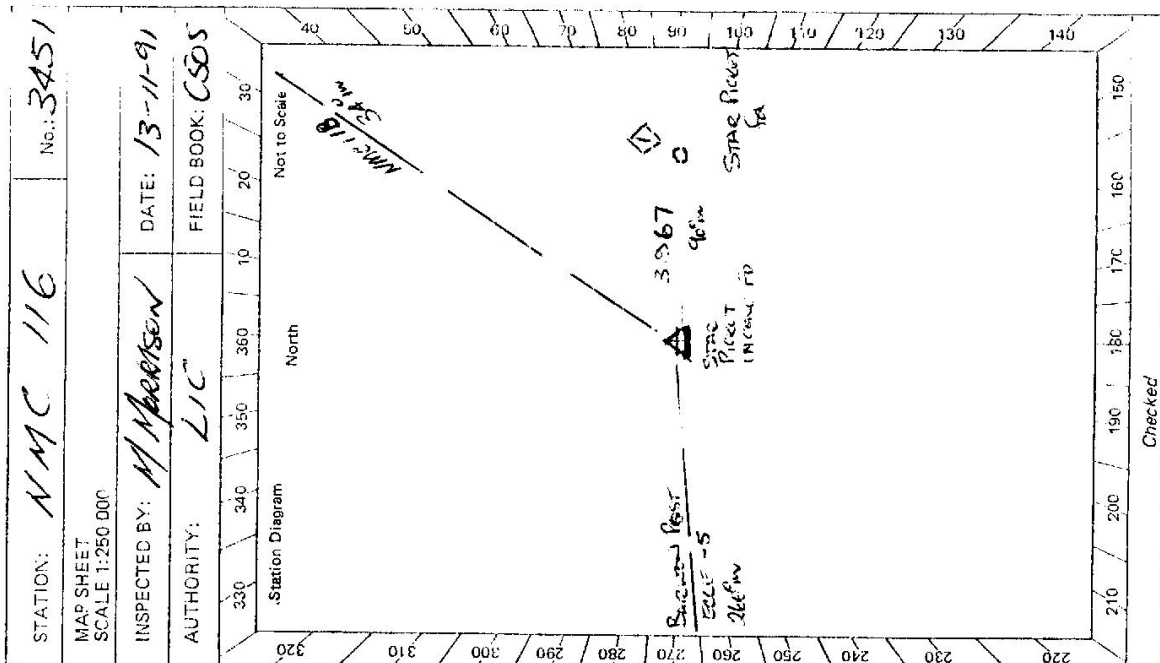

LAND INFORMATION CENTRE

GEODETIC SURVEY OF N.S.W.

BATCH 1504

GEODETIC STATION RECONNAISSANCE and MAINTENANCE REPORT

Description:

1. Cleared by lanes bearing LANE TO BARWON RIVER POST 2 N 44° E 118 from Trig. Mast

2. Mast & Vanes have been painted white & black respectively.

3. The station/pillar was unpiled/not unpiled/constructed on 19....., dimensions now being:
STAR PICKET IN GRASS WITH CONC COLLAR

Description of mark.....should be explicit, e.g., S/Steel Pillar Plate, Steel plug. Brass plug. Bolt, G.I. Pipe

Height of mark.....m. above rock/concrete; Mark is.....m. above G.L.

Height of Top Vanes to Top Mark/Pillar platem. Diameter of Vanes (vertical).....m.

Height of Cairn.....m. Diameter of Cairn.....m. Name Plate found/not found/placed.

Length of Mastm. (approximate if not unplied)

4. A.....set in conc/rock has been placed/found, bearing.....°M from Mast/Plug/Pillar

5. A.....set in conc/rock has been placed/found, bearing.....°M from Mast/Plug/Pillar

6. A.....set in conc/rock has been placed/found, bearing.....°M from Mast/Plug/Pillar

7. A.....set in conc/rock has been placed/found, bearing.....°M from Mast/Plug/Pillar

8. Action required:.....

STANDPOINT:

STANDPOINT:

| Mark | Direction | Horiz. Distance | Height Difference | Mark | Direction | Horiz. Distance | Height Difference |
|------|-----------|-----------------|-------------------------|------|-----------|-----------------|-------------------------|
| | | | above standpt. below | | | | above standpt. below |
| | | | above standpt. below | | | | above standpt. below |
Checked:

Noted on U.T.M. Card

Checked


S: 2733-1

STATION: NMC 116 TS No.: 3451

MAP SHEET S7 GEORGE
SCALE 1:250 000 MUNGINDI (BARWON RIVER)

INSPECTED BY: G. FORD DATE: MARCH 1991

AUTHORITY: L.I.C. FIELD BOOK: ---

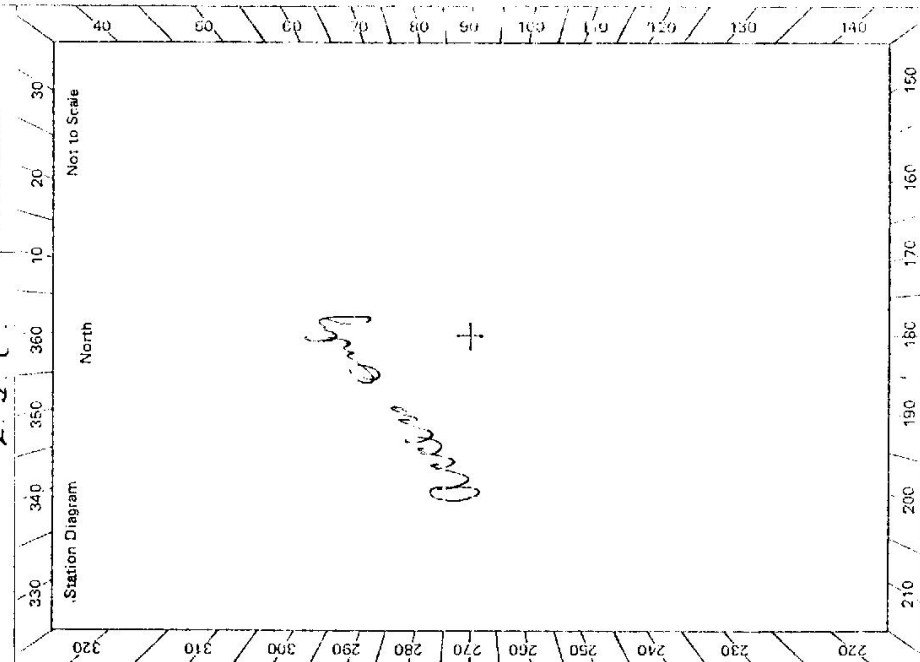

N M C 116 TS 3451

Owner's Name: MUNGINDI COMMON

Current Occupant:

Address:

Address:

Phone:

Phone:

March 1991

ACCESS

Access Report of...../19.....was found suitable/unsuitable.

0.00 POLICE STATION MUNGINDI GO ALONG MEQUIL ST TOWARDS RAKE COURSE

0.67 TURN LEFT

1.09 LEFT ON TO BLACK SOIL TRACK

2-37 IRON GATE (GO THROUGH) ON LEFT BEFORE HOUSE NEAR RIVER BANK

2. 84 LOCKED GATE AT YARDS VEER LEFT THROUGH OPENING THEN ROUND TO RIGHT

2.2 SHELTON CO. CT

3.88 SLIGHT DEPRESSION

3.91 NM 116

(MARK ABOUT 18 MILES EAST OF TRACK & ABOUT 50 METERS BEFORE BANK OF LARSEN CREEK)

Date _____

Record of Station

UNIT TO SCALE

Not to Scale

Beacon Diagram

HEV

MR. RICHARD MCMAHON

| | | | | |
|----|----------|-------|------|---------|
| AT | Takeaway | CAFE | OPP | BARRON |
| | | RIVER | PARK | 710 7PM |

OR

MR CUN

(067) 532137

Access and Locality Sketch: From Mungindi Police Station by gravel road for first 1.6km, then black soil track. The access is very boggy when wet. The situation is a drive on.

situation is a drive on.
2. TAKE AWAY BARNON
1 TAKE AWAY OFF BARNON

WALLS
CAPE
AND

532137

✓ New Tax Locks D

6272

u4/ A O Bazed