

**LAND INFORMATION CENTRE**

GEODETTIC SURVEY OF A.S.W.

**GEODETTIC STATION RECONNAISSANCE and MAINTENANCE REPORT**

Description:

1. Cleared by lances bearing.....  
 Note: Cross out word or words which do not apply  
 ..... from Trig. Mast

2. Mast & Vanes have been painted white & black respectively.

3. The station/pillar was unpiled/not unpiled/constructed on.....19....., dimensions now being:

Description of mark.....should be explicit, e.g., S/Steel Pillar Plate, Steel plug, Brass plug, Bolt, G.I. Pipe

Height of mark.....m. <sup>above</sup> rock/concrete; Mark is.....m. <sup>above</sup> <sub>below</sub> G.L.

Height of Top Vanes to Top Mark/Pillar plate .....m. Diameter of Vanes (vertical).....m.

Height of Cairn.....m. Diameter of Cairn.....m. Name Plate found/not found/placed.

Length of Mast .....m. (approximate if not unpiled)

4. A..... set in conc./rock has been placed/found, bearing.....° M from Mast/Plug/Pillar

5. A..... set in conc./rock has been placed/found, bearing.....° M from Mast/Plug/Pillar

6. A..... set in conc./rock has been placed/found, bearing.....° M from Mast/Plug/Pillar

7. A..... set in conc./rock has been placed/found, bearing.....° M from Mast/Plug/Pillar

8. Action required:.....

**STANDPOINT:**

Mark	Direction	Horiz. Distance	Height Difference	Mark	Direction	Horiz. Distance	Height Difference
			above standpt.				above standpt.
			below				below
			above standpt.				above standpt.
			below				below
**STANDPOINT:**

Mark	Direction	Horiz. Distance	Height Difference
			above standpt.
			below
			above standpt.
			below
Prepared by: *G Ford* 19/4/91

Checked: *L. I. C.* 2/5/91 Noted on U.T.M. Card

STATION: *NMC 185* TS No.: *3464*

MAP SHEET SCALE: *1:100,000*


INSPECTED BY: *G FORD* DATE: *MARCH 1991*

AUTHORITY: *L. I. C.* FIELD BOOK: *—*

Station Diagram

Not to Scale

WEILMORINGLE 8239

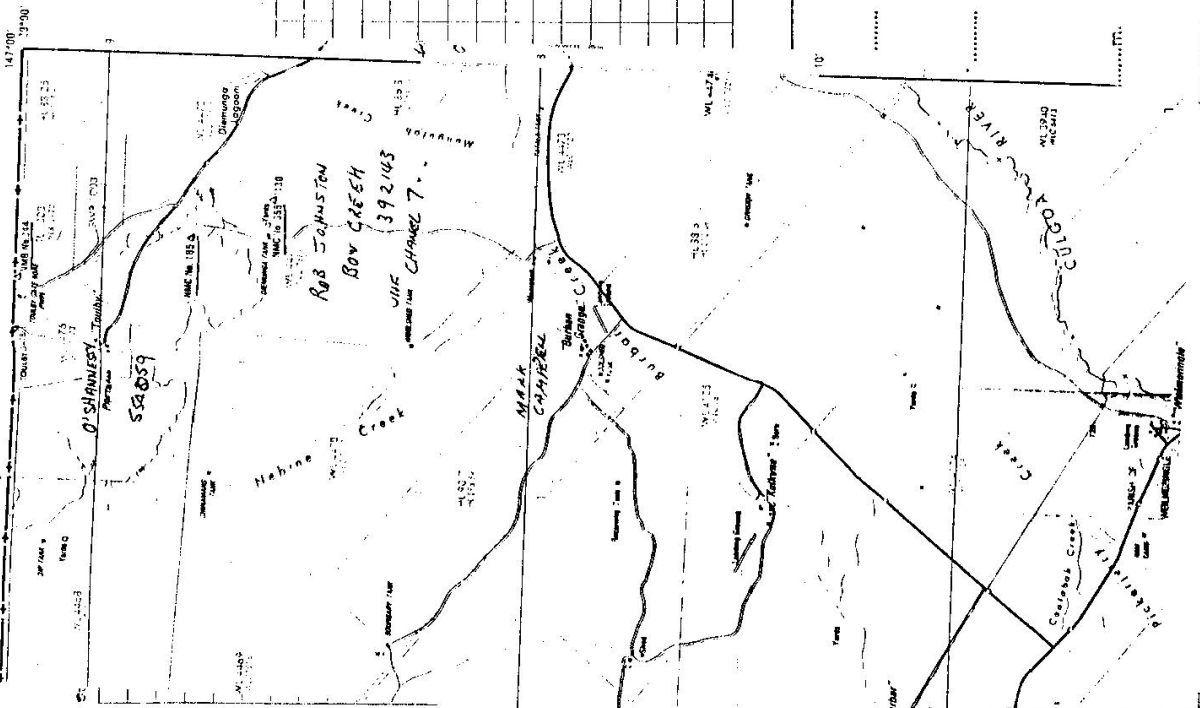

STATION		NMC 185 TS 3464	
Owner:	NMC 185		
Address:	WEILMORINGLE 1: 100.000		
Phone:			
Access:	0:00	TOLBY HOMESTEAD	
	0:07	IRON GATE TOLBY (ENTRANCE N.S.W. SIDE)	(ABOUT 42 KM FROM WEILMORINGLE VILLAGES)
	4:9	TURN RIGHT OFF TRACK (ABT 250 METRES BEFORE GATE)	
		TO OLD GRAVEL PIT	
	5:14	DAM ON L.H.S.	
	5:23	OLD QUARRY NEAR 270°M	
	6:11	HEAD 295°M	
	6:34	ENTERING CLEARING. HEAD 295°M	
	6:84	NMC 185 LARGE CLEARED AREA.	
<p><i>All Muck stable as there</i></p> <p><i>Land owner wants to place an air strip where these Muck are located.</i></p> <p><i>Clear For G. P. S.</i></p> <p><i>Rob Johnson</i></p> <p><i>PH 392143 (Not same of 068 or 074 Area Code)</i></p> <p><i>UHF channel 7</i></p> <p><i>Does Not lie on the Land but must be contacted.</i></p>			
Date:			