


**LAND INFORMATION CENTRE** *GEODETTIC SURVEY OF N.S.W.* **Batch 1700**  
**GEODETTIC STATION RECONNAISSANCE and MAINTENANCE REPORT**

**NCA —**  
 STATION: **NMC 031** No.: **3468**  
 MAP SHEET SCALE 1:250 000 **BARNATO**  
 INSPECTED BY: **A. Sivertsen** DATE: **10.3.95**  
 AUTHORITY: **LIC** FIELD BOOK: **—**

Description:  
 1. Cleared by lanes bearing **surrounded 360° by scrub** from Trig. Mast  
 2. Mast & Vanes have been painted white & black respectively. **OK for GPS**  
 3. The station/pillar was unpiled/not unpiled/constructed on..... 19....., dimensions now being:  
 Description of mark.....should be explicit, e.g., S/Steel Pillar Plate, Steel plug, Brass plug, Bolt, G.I. Pipe  
 Height of mark.....m..... <sup>above</sup> <sub>below</sub> rock/concrete; Mark is.....m..... <sup>above</sup> <sub>below</sub> G.L.  
 Height of Top Vanes to Top Mark/Pillar plate .....m. Diameter of Vanes (vertical).....m.  
 Height of Cairn.....m. Diameter of Cairn.....m. Name Plate found/not found/placed.  
 Length of Mast .....m. (approximate if not unpiled)  
 4. A.....<sup>set in conc/rock</sup> has been placed/found, bearing.....°M from Mast/Plug/Pillar  
 5. A.....<sup>set in conc/rock</sup> has been placed/found, bearing.....°M from Mast/Plug/Pillar  
 6. A.....<sup>set in conc/rock</sup> has been placed/found, bearing.....°M from Mast/Plug/Pillar  
 7. A.....<sup>set in conc/rock</sup> has been placed/found, bearing.....°M from Mast/Plug/Pillar  
 8. Action required:.....

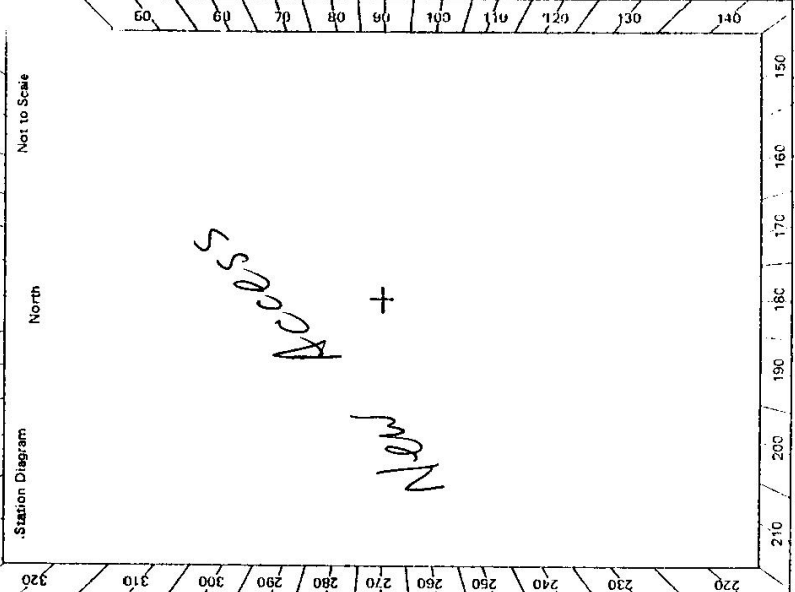

STANDPOINT:				STANDPOINT:			
Mark	Direction	Horiz. Distance	Height Difference	Mark	Direction	Horiz. Distance	Height Difference
			above standpt.				above standpt.
			below standpt.				below standpt.
			above standpt.				above standpt.
			below standpt.				below standpt.
Prepared by:.....  
 Checked:.....  
 Noted on U.T.M. Card

NCA - 3468  STATION NM C 31 TS 3468	Owner's Name: <u>John ELLIOT</u> Address: <u>"MOIRA PLAINS"</u> Phone: <u>080 919492</u> Current Occupant: ..... Address: ..... Phone: ..... ACCESS <u>Zwid (dry) MAR 95</u> Access Report of ...../...../19 ..... was found suitable/unsuitable. 0.0 <u>EMMDALE roadhouse travel towards WILCANNIA</u> 13.2 <u>PASS IVANICE via BADEN PARK rd on L</u> 23.9 <u>Turn L thru gate at mailbox</u> 26.3 <u>PASS track on R</u> 33.5 <u>Take L fork "MOIRA PLAINS"</u> 45.3 <u>Gate "MOIRA PLAINS"</u> 45.8 <u>At rear of homestead Gallow track to L past tennis court &amp; cottage</u> 46.0 <u>Gate then L fork</u> 46.8 <u>Gate</u> 46.9 <u>Shearing shed on R of huts on L</u> 47.1 <u>Gate then R fork</u> 51.8 <u>" " "</u> 52.0 <u>Straight ahead</u> 56.5 <u>R fork</u> 56.7 <u>Gate then go L</u> 56.9 <u>Take R fork 261 30m before gate.</u> 57.45 <u>At steel pipe fence post head 290°M.</u> towards scrubby red sandy hill (second rise you come to) 59.0 <u>Turn L along dune</u> 59.1 <u>NM C 031 on R</u>
Beacon Diagram No: to Scale	This section to be completed by officer constructing pillar. Original station mark found/not found. Description of mark: ..... Original beacon found/not found. Description of beacon: ..... Height: Top of Vanes to Top Mark.....m. Height of mark.....m. above rock/conc.....m. below G.L. Diameter of Vanes.....m. Height of Cairn.....m. Original Beacon has/has not been destroyed by me.
Date	Record of Station