

10730

Australian Army

NM/C/34

STATION DESCRIPTION

F 574 22  
Intro Jul 79

Station No NM/C/34 - 10730 DOPPLER SATELLITE STATION

Original station established by DIVISION OF NATIONAL MAPPING

Station mark consists of A 2CM DIA. COPPER TUBE SET IN A 2CM SQUARE MOULDED BLOCK OF CONCRETE STAMPED NM/C/34

Reference marks CONSISTS OF THREE STEEL PICKETS, DRIVEN FLUSH WITH THE GROUND, CEMENTED AND CENTRE PUNCHED STATION RECOVERY OBSERVATIONS ACREE EXACTLY AS PER ORIGINAL NATIONAL MAPPING SUMMARY

Beacon Nil. 4 CAPPED GAS PIPES OF 40MM DIA SURROUND THE GM. FORMING A 1.5M SQUARE, AND PROTRUDE 10CM ABOVE GROUND LEVEL.

Station NM/C/34 IS SITUATED ON TOP OF A HIGH SAND RIDGE (THE HIGHEST IN THE IMMEDIATE AREA), APPROX 10 KM SWD OF 'KARPA KORA' HOMESTEAD.

Access WAS BY VEHICLE FROM THE 'SAVER'S LAKE - BOUCARIE' RD, CONTINUE WEST FROM A T-JUNCTION SIGNPOSTED 'BOUCARIE 8.5KM' TO A TRACK HEADING SW. TO 'KARPA KORA' H.S. CONTINUE WEST APPROX 6.5 KM TO A GRASSY TURN SW ON THE WEST SIDE OF THE FENCE, DOWN A GRASSY TRACK FOR APPROX 1.5 KM, THROUGH AN E-W FENCE, TURN EAST CONTINUING FOR APPROX 100M TO A GRASSY TRACK, SIGNPOSTED 'PADDY'S TANK' HEADING SW. FOLLOW THIS TRACK SW FOR APPROX 4.0 KM TO A TWIN DAM CONFIGURATION, AROUND THE DAMS AND FOLLOW THE REMAINS OF A STRIP PAVED FENCE IN A S.W. DIRECTION FOR APPROX 0.8 KM BEFORE HEADING SW ALONG THE REMAINS OF A OLD WOODEN FENCE FOR APPROX 1.0 KM TO THE CREST OF A HIGH SAND RIDGE, THEN WEST 0.6 KM ALONG ROAD TRACK TO

Visibility from GM UNRESTRICTED IN ALL DIRECTIONS.

Photo Identification MANARRA RUN B CAL 232 / SPOT PHOTOGRAPHY PANELS OF 1.8M X 6M WHITE PLASTIC LAID IN --- CONFIGURATION.

Availability of helicopter landing zones HELICOPTERS CAN LAND CLOSE TO THE STATION WHILE OCCUPIED

Other general information FOOD AND WATER NEED TO BE BROUGHT ON STATION. FUELWOOD AVAILABLE ACCESS BY LAND VEHICLE ONLY. ALTERNATE ACCESS MAY BE GAINED AS PER ORIGINAL NAT. MAPPING STATION SUMMARY, DATED 1962


Compiled by R. Clark 2LT (DE CLARK) Signature  
Checked by W. Gilbert Capt (W Gilbert) Signature  
Date 10 Feb 80 (Date)

Department of Defence

# LOCATION & ACCESS DIAGRAM

Stock No 7530-46-099-7915

NM/C/34 - 10730 DOPPLER SATELLITE STATION

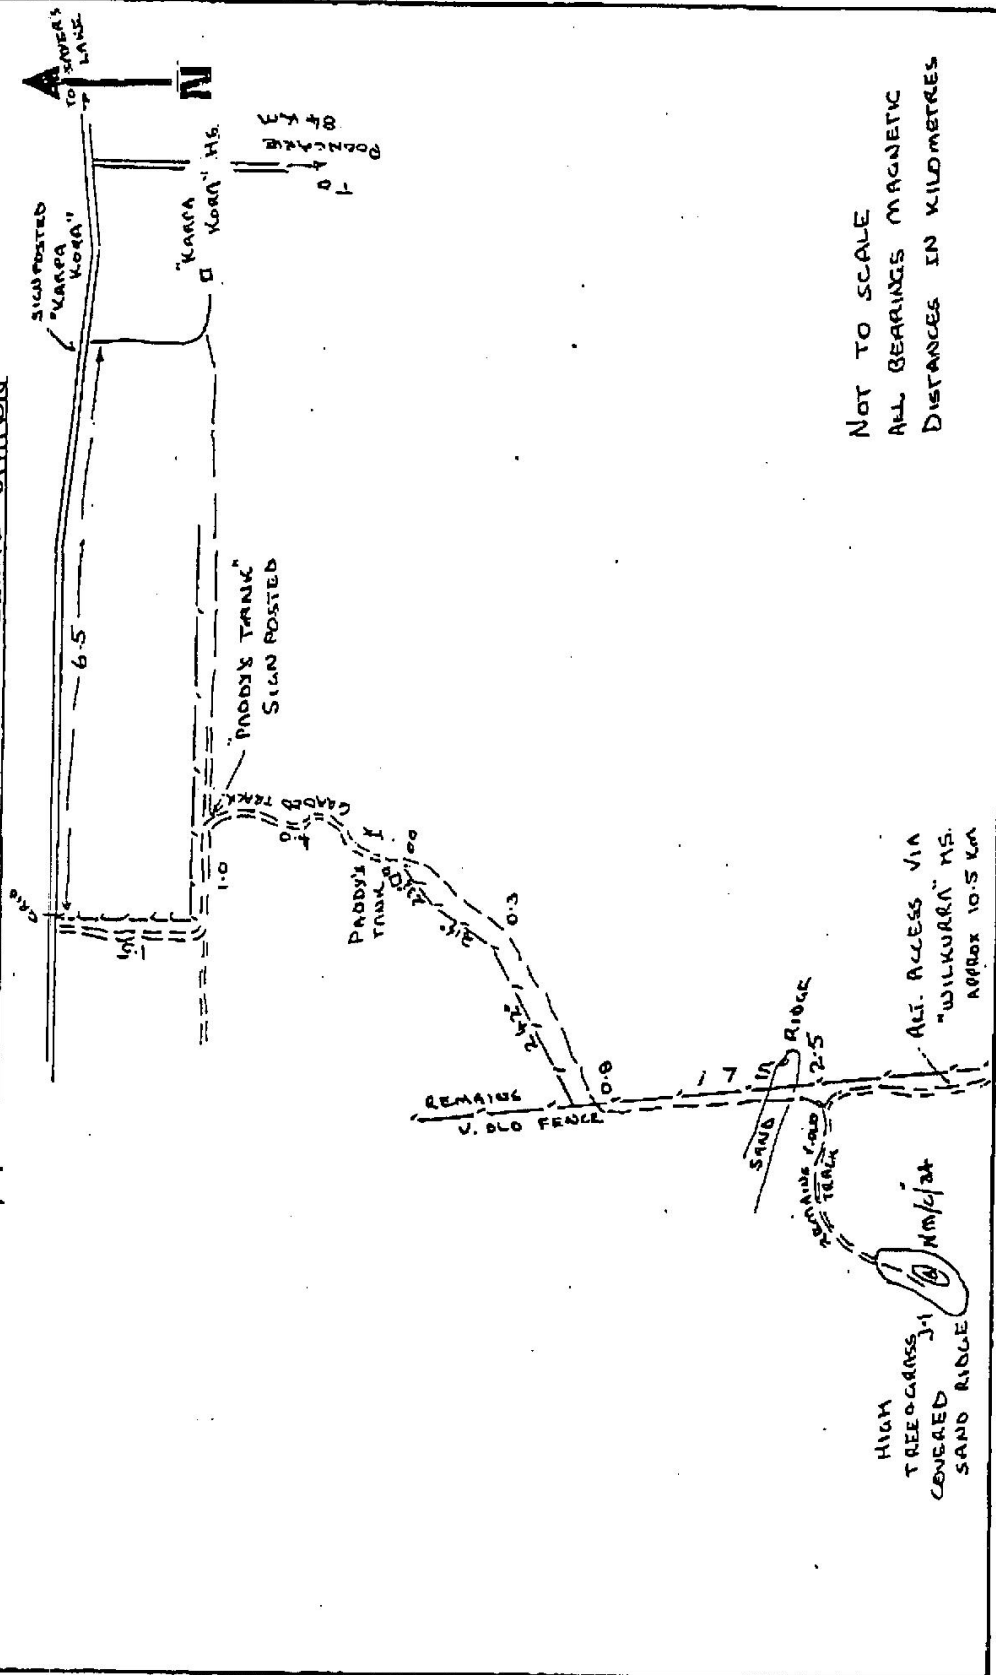

NOT TO SCALE  
ALL BEARINGS MAGNETIC  
DISTANCES IN KILOMETRES

17 FSVY 21  
and Oct 78

COMPILED *P. Clark* (P.E. CLARK) CHECKED *A. Bowles* (A.P. BOWLES) 20 Feb 80