

CENTRAL MAPPING AUTHORITY

GEODETIC SURVEY OF N.S.W.
 GEODETIC STATION RECONNAISSANCE and MAINTENANCE REPORT

STATION: NM/C/43 No.: 3481

MAP SHEET
 SCALE 1:250 000 WALGETT

INSPECTED BY: D. FREDRIKSEN DATE: 10/7/79

AUTHORITY: C.M.A. FIELD BOOK:

Description:
 1. Cleared by lanes bearing..... from Trig. Mast

2. Mast & Vanes have been painted white & black respectively.

3. The station/pillar was unpiled/not unpiled/constructed on....., dimensions now being:

Description of mark.....should be explicit, e.g., S/Steel Pillar Plate, Steel

Height of mark.....m. ^{above}/_{below} rock/concrete; Mark is.....m. ^{above}/_{below}

Height of Top Vanes to Top Mark/Pillar platem. Diameter of

Height of Cairn.....m. Diameter of Cairn.....m. Nar

Length of Mastm. (approximate if not unpiled)

4. A.....set in conc/rock has been placed/found, bearing.....°M

5. A.....set in conc/rock has been placed/found, bearing.....°M

6. A.....set in conc/rock has been placed/found, bearing.....°M

7. A.....set in conc/rock has been placed/found, bearing.....°M

8. Action required.....

Bearings are true;
 Distances are in metres;
 R.M.s are steel star pickets driven flush, centre punched, and set in concrete;
 R.O. is nail in blaze on dead tree approx. 135 metres from station.

Note: This tree also has a boundary blaze on it
 Nat. Map blaze is above this


STANDPOINT:		STANDPOINT:	
Mark	Direction	Horiz. Distance	Height Difference
			above standpt
			below
			above standpt
			below
Prepared by:

Checked:

Noted on U.T.M. Card

Checked

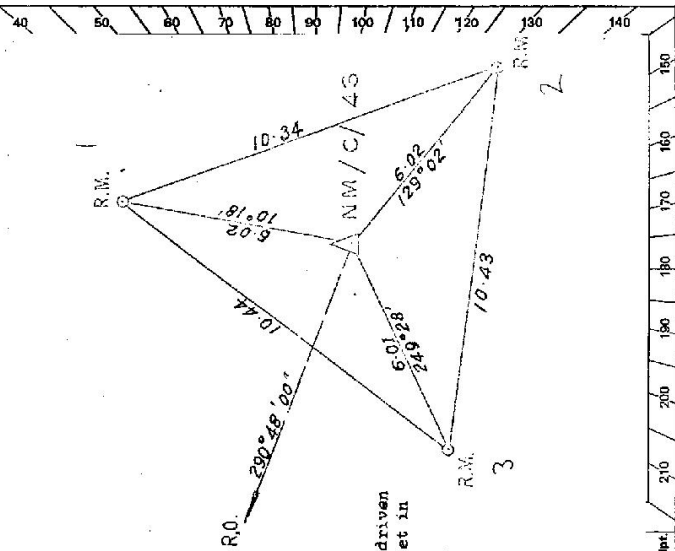

#1 2733--2 D. West, Government Printer Beacon Diagram Not to Scale	STATION NM/C/43 IS 3481 Owner's Name: Current Occupant: Address: Phone: Phone: ACCESS Access Report of 10/7/1974 was found suitable/unsuitable.		Record of Station Date
This section to be completed by officer constructing pillar. Original station mark found/not found. Description of mark: Original beacon found/not found. Description of beacon: Height Top of Vanes to Top Mark m. Height of mark m. above rock/conc m. below G.L. Diameter of Vanes m. Height of Cairn m. Original Beacon has/has not been destroyed by me.			Date Record of Station

CENTRAL MAPPING AUTHORITY
 GEODETTIC SURVEY OF N.S.W.
 Batch 1506
 GEODETTIC STATION RECONNAISSANCE and MAINTENANCE REPORT

STATION: NM/C/043 No.: 3481

MAP SHEET
 SCALE 1:250 000
 INSPECTED BY: I. W. Robins
 DATE: 25.2.81

AUTHORITY: C.M.A.
 FIELD BOOK: C63

Description: *Note: Cross out word or words which do not apply*

1. Cleared by lanes bearing: *from Trig Mast*

2. Mast & Vanes have been painted white & black respectively:

3. The station/pillar was supplied/not supplied/constructed on: *19* dimensions now being:

Description of mark: *Cu pipe in Conc*; should be explicit, e.g., S/Steel Pillar Plate, Steel plug, Bolt, G.I. Pipe


Height of mark: *0.0* m. *above* rock/concrete; Mark is *0.15* m. *above* G.L.

Height of Top Vanes to Top Mark/Pillar plate: *0* m. Diameter of Vanes (vertical):

Height of Cap: *0* m. Diameter of Cap: *0* m. Name Plate found/not found/plate:

Length of Mast: *0* m. (approximate if not templated)

4. A. *Four gal. iron witness posts set in conc; each about 1m from mast were found*
5. A. *No RM's searched for.*
6. A. *RO GIN in tree searched for but not found.*
7. A. *RO GIN in tree searched for but not found.*
8. Action required: *lane to NM/C/074 will need to be cleared if required to be used.*

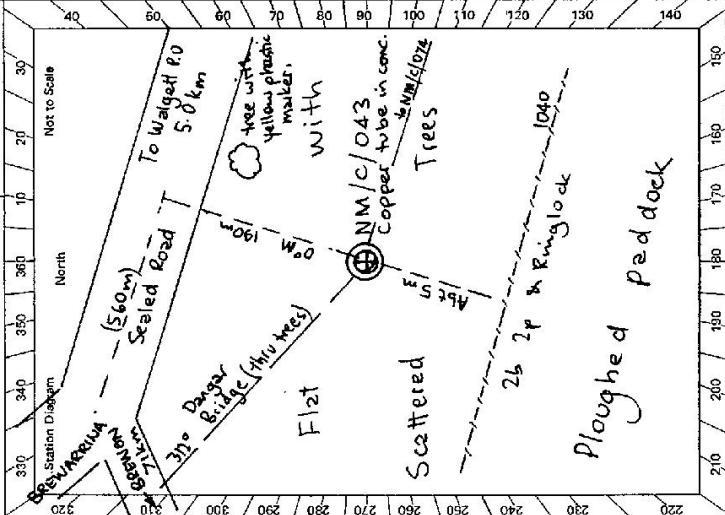


STANDPOINT:

Mark	Direction	Horiz. Distance	Height Difference	Mark	Direction	Horiz. Distance	Height Difference
			above standpt.				above standpt.
			below				below
			above standpt.				above standpt.
			below				below
Prepared by: *David W. Tol* Checked: *2.3.81*
 Noted on U.T.M. Card

ST 2733-1
 Checked

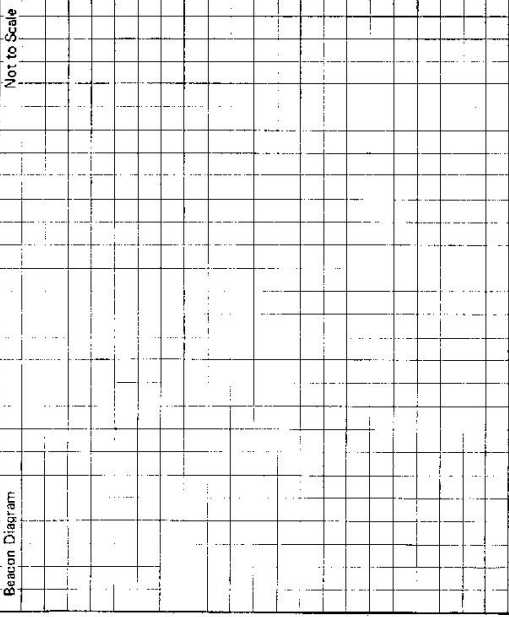ST 2723 - 2 D. West Government Printer Beacon Diagram	Not to Scale 	STATION NM/C/043 TS 3481 Owner's Name: Public Road Address: Phone: Current Occupant: Address: Phone: ACCESS 25-2-81 Access Report of 19-10-19 was found suitable/unstable. km 0.0 Post Office Wajgett: head west on Brewarions Road (Wae Waa Street) 5.0 Lease road & turn left on bearing 180° Way. at yellow marker nailed to tree beside road on left 5.2 NM/C/043; 5m North of fence.
This section to be completed by officer constructing pillar. Original station mark found/not found. Description of mark: Original beacon found/not found. Description of beacon: Height Top of Vanes to Top Markm. Height of mark:m. above rock/conc.m. below G.L. Diameter of Vanesm. Height of Cairnm. Original Beacon has/has not been destroyed by me.		Date Record of Station