

CENTRAL MAPPING AUTHORITY

GEODETIC SURVEY OF N.S.W.

GEODETIC STATION RECONNAISSANCE and MAINTENANCE REPORT

STATION: NM/C/49 No.: 3487

Description: *Note: Cross out word or words which do not apply*

1. Cleared by lances bearing..... from Trig. Mast

2. Mast & Vanes have been painted white & black respectively.

3. The station/pillar was unpiled/not unpiled/constructed on.....19....., dimensions now being:

Description of mark.....should be explicit, e.g. S/Steel Pillar Plate, Steel plug, Brass plug, Bolt,

Height of mark.....m. above below rock/concrete; Mark is.....m. above below G.L.

Height of Top Vanes to Top Mark/Pillar platem. Diameter of Vanes (vertical).....

Height of Cairn.....m. Diameter of Cairn.....m. Name Plate found/not found

Length of Mastm. (approximate if not unpiled)

4. A.....set in conc/rock has been placed/found, bearing.....°M from Mast/Plug/Pill

5. A.....set in conc/rock has been placed/found, bearing.....°M from Mast/Plug/Pill

6. A.....set in conc/rock has been placed/found, bearing.....°M from Mast/Plug/Pill

7. A.....set in conc/rock has been placed/found, bearing.....°M from Mast/Plug/Pill

8. Action required.....


MAP SHEET SCALE 1:250 000

INSPECTED BY: D. FREDRIKSEN

DATE: 6/7/79

AUTHORITY: C. M. A.

FIELD BOOK: 1562

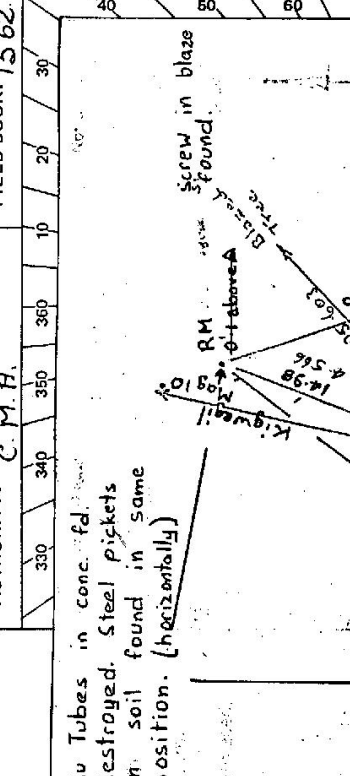

Cu Tubes in conc. fd. destroyed. Steel pickets in soil found in same position. (horizontally)

RM found

RM C149

Witness Post

Power Pole

Screw in blaze

RM C149

Witness Post

Power Pole

Screw in blaze

RM found

RM C149

Witness Post

Power Pole

Screw in blaze

RM found

RM C149

Witness Post

Power Pole

Screw in blaze

RM found

RM C149

Witness Post

Power Pole

Screw in blaze

RM found

RM C149

Witness Post

Power Pole

ISSUE NO. 2
DATE: 29 JUL 1979

Prepared by: D. Fredriksen 6/7/79

Checked:

Noted on U.T.M. Card

31 2733-1

St: 2733-2 D. West, Government Printer

Beacon Diagram		Not to Scale
<div style="text-align: right; padding-right: 10px;"> <p>STATION <u>NM/C/49</u> TS <u>3487</u></p> </div>	<p>Owner's Name:</p> <p>Address:</p> <p>Phone:</p> <p>Current Occupant:</p> <p>Address:</p> <p>Phone:</p> <p><u>ACCESS</u></p> <p>Access Report of <u>6/7/1979</u> was found suitable/unsuitable.</p> <p><u>KMS</u> <u>FEATURE</u></p> <p><u>0.0</u> BURKEN JUNCTION P.D. head towards Collarenebri # Walgett.</p> <p><u>2.1</u> Railway crossing</p> <p><u>5.0</u> Turn LEFT towards WALGETT</p> <p><u>7.2</u> Pass house on R.M.S. see owner for permission.</p> <p><u>9.3</u> Turn RIGHT off road third gate on right.</p> <p><u>9.35</u> Turn RIGHT and follow single wire power line of about 76'M</p> <p><u>10.35</u> At NM/C/49 see sketch.</p>	
<p>This section to be completed by officer constructing pillar.</p>		
<p>Original station mark found/not found.</p> <p>Description of mark:</p> <p>Original beacon found/not found.</p> <p>Description of beacon:</p> <p>Height Top of Vanes to Top Mark.....m.</p> <p>Height of mark.....m. above G.L. below rock/conc.....m. below</p> <p>Diameter of Vanes.....m. Height of Cairn.....m.</p> <p>Original Beacon has/has not been destroyed by me.</p>		
	Date	Record of Station