


CENTRAL MAPPING AUTHORITY

GEODETIC SURVEY OF N.S.W.
 GEODETIC STATION RECONNAISSANCE and MAINTENANCE REPORT

Description: Note: Cross out word or words which do not apply

- Cleared by lanes bearing.....
- Mast & Vanes have been painted white & black respectively.
- The station/pillar was unpiled/not unpiled/constructed on..... 19....., dimensions now being:
 - Description of mark.....should be explicit, e.g., S/Steel Pillar Plate, Steel plug, Brass plug, Bolt
 - Height of mark.....m. ^{above} _{below} rock/concrete; Mark is.....m. ^{above} _{below} G.L.
 - Height of Top Vanes to Top Mark/Pillar platem. Diameter of Vanes (vertical).....
 - Height of Cairn.....m. Diameter of Cairn.....m. Name Plate found/not found
 - Length of Mastm. (approximate if not unpiled)
 - 4. A.....set in conc/rock has been placed/found, bearing.....°M from Mast/Plug/Pill
 - 5. A.....set in conc/rock has been placed/found, bearing.....°M from Mast/Plug/Pill
 - 6. A.....set in conc/rock has been placed/found, bearing.....°M from Mast/Plug/Pill
 - 7. A.....set in conc/rock has been placed/found, bearing.....°M from Mast/Plug/Pill
- Action required:.....

STATION: NM/C/50 No.: 3488
 MAP SHEET SCALE 1:250 000 NARRABRI
 INSPECTED BY: D. FREDRIKSEN DATE: 6/7/79
 AUTHORITY: C.M.A FIELD BOOK: ---

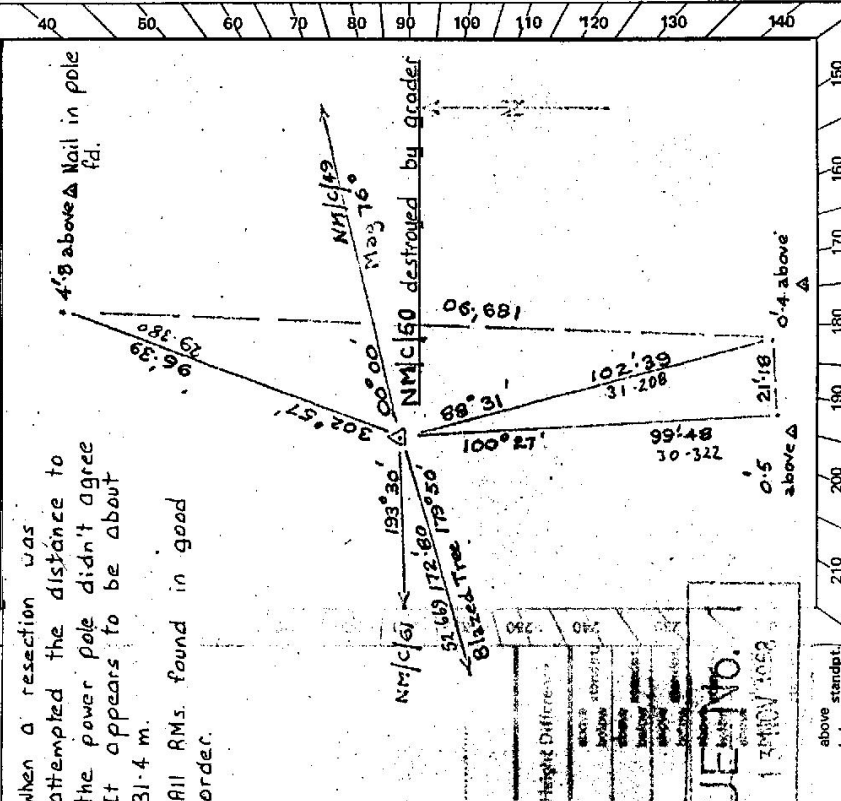

When a resection was attempted the distance to the power pole didn't agree. It appears to be about 31.4 m. All RMs. found in good order.

STANDPOINT:

Mark	Direction	Horiz. Distance	Height Difference	Mark	Direction	Horiz. Distance
			above standpt.			
			below			
			above standpt.			
			below			
Prepared by: D. Fredrikson 30/10/79 Checked: --- Noted on U.T.M. Card

STATION NM/C/50 TS 3488


Current Occupant:
 Address:
 Phone:
ACCESS 6-7-1979
 .../19..... was found suitable/unsuitable.

Particulars of station marking and beacon:

STATION MARK : 2" diam. copper tube set in concrete block marked NM C 50. Block is reinforced by an 18" length of G.I. pipe directly below the copper tube.

REFERENCE MARKS : Two 1/2" diam. copper tubes in concrete blocks, one nail in centre of blaze on tree, and one nail in centre of red shield painted on an electric power pole.

ACCESS : NM C 50 is sited on the edge of the drainage channel on the south side of the Burren Junction-Malgett road. Easy access as shown. Views are restricted to about one mile to the east and three miles, directly down the road, to the west. To obtain even this, the station had to be sited very close to the road. A blazed tree and red painted shield on power line pole indicate the station; a half-circular trench (radius 6') has been dug on the south side of the mark, the drainage channel being too close on the north to complete the circle.

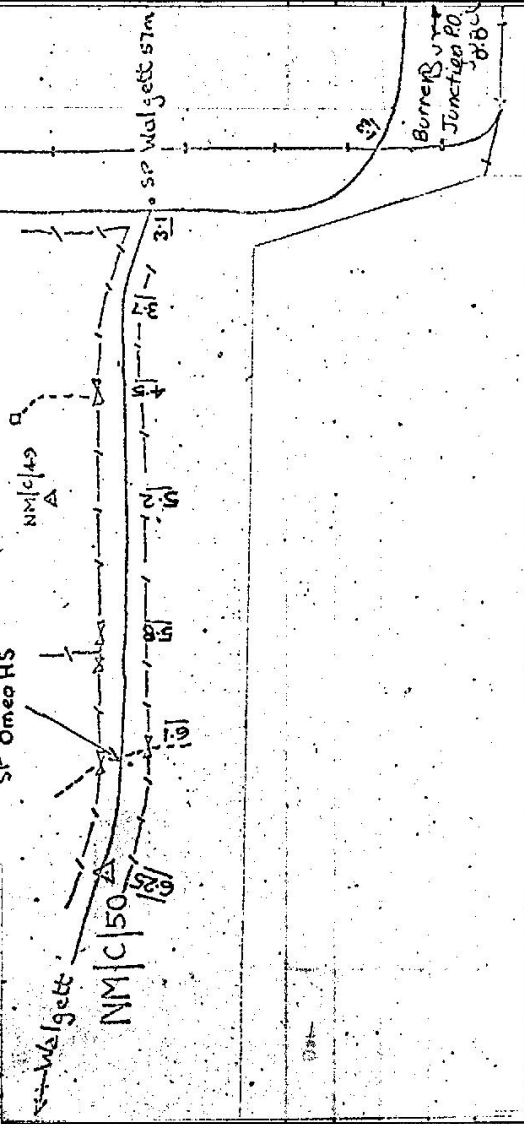

This section to be completed by officer constructing pillar.	
Original station mark found/not found.
Description of mark:
Original beacon found/not found.
Description of beacon:
Height Top of Vanes to Top Mark.....m.
Height of mark.....m. above G.L. below rock/conc.....m.
Diameter of Vanes.....m.
Original Beacon has/has not been destroyed by me.