

GEODETIC SURVEY OF N.S.W.

CENTRAL MAPPING AUTHORITY

GEODETIC STATION RECONNAISSANCE and MAINTENANCE REPORT

Access and Locality Sketch:

Particulars of station marking and beacon: *to apply*

STATION MARK:
 A 1/2" diameter copper tube inserted in 2" diameter G.I. pipe which was driven into ground. A concrete block marked NM/C/63 was formed around the pipe.

REFERENCE MARKS:
 Three 1/2" diameter copper tubes inserted in 2" diameter G.I. pipes set in concrete blocks. One roofing nail in centre of red painted shield on power line pole. One 2" diameter steel witness post on line to NM/C/62.

ACCESS:
 NM/C/62 is situated between the road and the railway line 6.5 miles east of Cryon. It is on the southern edge of a graded side track which runs between the road and the railway, as shown. The station is marked with a half circle, 12" diam. trench and sited in flat, mostly cultivated country. A 30' tower was needed for all observations and measurements.

4. A.....set in conc/rock has been placed/found, bearing.....°M from Mast/Plug/Pillar
5. A.....set in conc/rock has been placed/found, bearing.....°M from Mast/Plug/Pillar
6. A.....set in conc/rock has been placed/found, bearing.....°M from Mast/Plug/Pillar
7. A.....set in conc/rock has been placed/found, bearing.....°M from Mast/Plug/Pillar

8. Action required:.....

STANDPOINT:				STANDPOINT:			
Mark	Direction	Horiz. Distance	Height Difference	Mark	Direction	Horiz. Distance	Height
			above standpt.				
			below				
			above standpt.				
			below				

Prepared by: D. Fredriksen 28/10/79 Checked: *Noted on U.T.M. Card*

STATION: NM/C/63 No.: 3497

MAP SHEET SCALE 1:250 000 NARRABRI

INSPECTED BY: D. Fredriksen DATE: 7/7/79

AUTHORITY: C.M.A. FIELD BOOK:

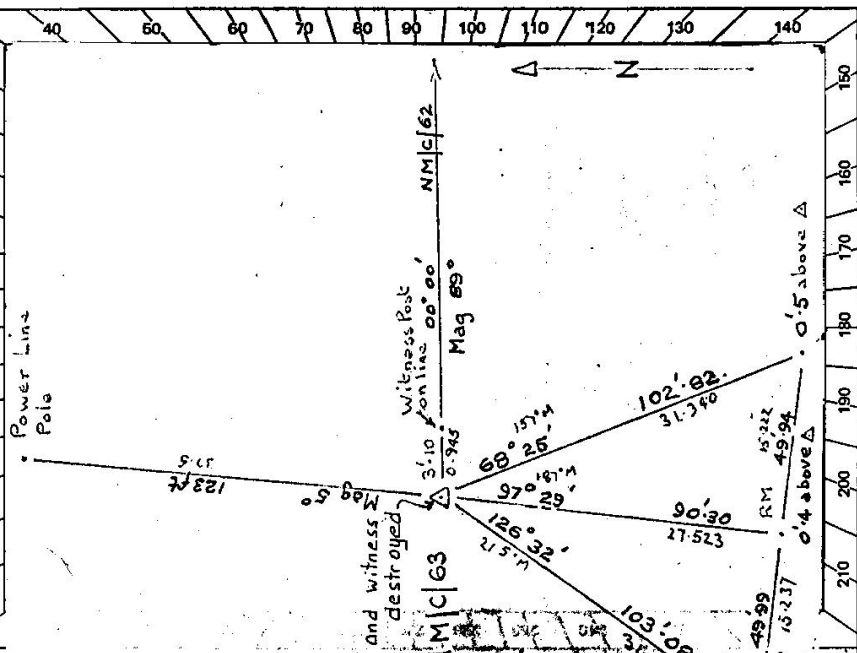

Checked

<p>STATION NM/C/63 TS 3497</p>	<p>Owner's Name:</p> <p>Address:</p> <p>Current Occupant:</p> <p>Address:</p>	
<p>Beacon Diagram</p> <p style="text-align: right;">Not to Scale</p>	<p>Access NM/C/63</p>	
<p>This section to be completed by officer constructing pillar.</p>		
<p>Original station mark found/not found.</p>		
<p>Description of mark:</p>		
<p>Original beacon found/not found.</p>		
<p>Description of beacon:</p>		
<p>Height Top of Vanes to Top Mark m.</p>		
<p>Height of mark m. above rock/conc. below G.L.</p>		
<p>Diameter of Vanes m. Height of Cairn m.</p>		
<p>Original Beacon has/hes not been destroyed by me.</p>		
	Date	Record of Station