

GEODETIC SURVEY OF M.S.W.

CENTRAL MAPPING AUTHORITY

GEODETIC STATION RECONNAISSANCE and MAINTENANCE REPORT

STATION: **NM/C/64** No.: **3498**
 MAP SHEET SCALE 1:250 000 **NARRABRI**
 INSPECTED BY: **D. Fredriksen** DATE: **7/7/79**
 AUTHORITY: **C.M.A.** FIELD BOOK:

Access and Locality Sketch: Particulars of station marking and beacon: *Apply*
 STATION MARK: $\frac{1}{2}$ " diameter copper tube inserted in .18" length of G.I. pipe set in concrete block which is marked with the station number.

REFERENCE MARKS: Three 3" diameter copper tubes in concrete blocks; three tower anchor bolts, one 2" diam. steel witness post painted red, and a red painted triangle on a telegraph pole, both marked with station number.


DESCRIPTION: **NM/C/64** is on an extensive black-soil plain 3.4 miles, by road, south of Cryon. The station is close beside the road to Yarradool, on the east side, and just south of a bore drain. A 12" diameter circular trench has been dug around the station mark. A 30' tower was needed for all observations and measurements at this station.

- Length of tower:ft. (approximate if not unpaired)
- 4. A..... set in conc/rock has been placed/found, bearing.....°M from Mast/Plug
 - 5. A..... set in conc/rock has been placed/found, bearing.....°M from Mast/Plug
 - 6. A..... set in conc/rock has been placed/found, bearing.....°M from Mast/Plug
 - 7. A..... set in conc/rock has been placed/found, bearing.....°M from Mast/Plug

8. Action required:.....

STANDPOINT:					
Mark	Direction	Horiz. Distance	Height Difference	Mark	Direction
			above standpt		
			below standpt		
			above standpt		
			below standpt		
Prepared by: **D. Fredriksen** 26/10/79 Checked: **Noted on U.T.M. Card**

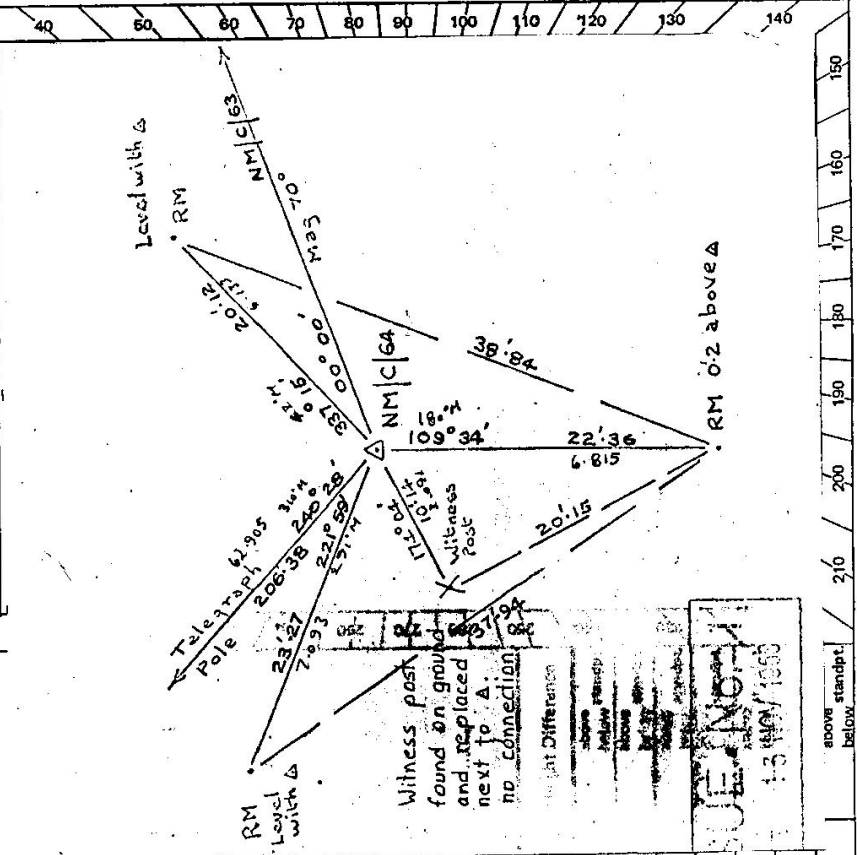


Checked

St 2733-2 D. West, Government Printer

Beacon Diagram	Not to Scale

Owner's Name:
 Address:
 Phone:
 Access Report

Date

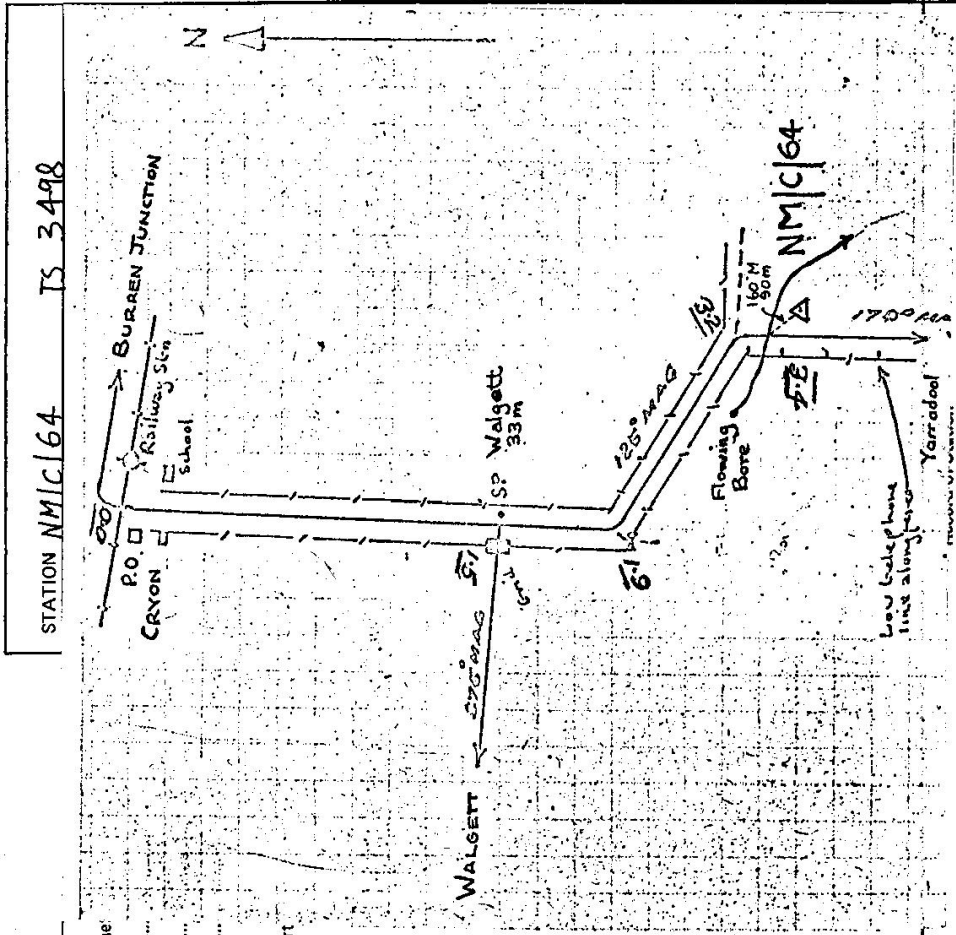

This section to be completed by officer constructing pillar.

Original station mark found/not found.

Description of mark:

Original beacon found/not found.

Description of beacon:

Height Top of Vanes to Top Mark.....m.

Height of mark.....m. above rock/conc.....m. above G.L. below

Diameter of Vanesm. Height of Cairnm.

Original Beacon has/not been destroyed by me.