

GEODETTIC SURVEY OF N.S.I.K

CENTRAL MAPPING AUTHORITY

GEODETTIC STATION RECONNAISSANCE and MAINTENANCE REPORT

STATION: **S.M.A. 1153** No.: **35**

MAP SHEET SCALE 1:250 000 **TANTANGARA 1:100,000**

INSPECTED BY: **R. COOK** DATE: **7-3-79**

AUTHORITY: **C.M.A.** FIELD BOOK:

Description: *Note: Cross out word or words which do not apply*

1. Cleared by lanes bearing..... from Trig, Mast

2. Mast & Vanes have been painted white & black respectively.

3. The station/pillar was unpiled/not unpiled/constructed on.....19....., dimensions now being:

Description of mark.....*Brass Plug*.....should be explicit, e.g., S/Steel Pillar Plate, Steel plug, Brass plug, Bolt, G.I. Pipe

Height of mark.....m.....*above* rock/concrete; Mark is.....m.....*above* G.I.

Height of Top Vanes to Top Mark/Pillar plate .....m. Diameter of Vanes (vertical).....m.

Height of Cairn.....m. Diameter of Cairn.....m. Name Plate found/not found/placed.

Length of Mast.....m. (approximate if not unpiled)

4. A.....set in conc/rock has been placed/found, bearing.....°M from Mast/Plug/Pillar

5. A.....set in conc/rock has been placed/found, bearing.....°M from Mast/Plug/Pillar

6. A.....set in conc/rock has been placed/found, bearing.....°M from Mast/Plug/Pillar

7. A.....set in conc/rock has been placed/found, bearing.....°M from Mast/Plug/Pillar

8. Action required: *Poor condition. Vanes have snapped off the legs. No clearing needed. 10 min walk.*

STANDPOINT:

Mark	Direction	Horiz. Distance	Height Difference	Mark	Direction	Horiz. Distance	Height Difference
			above below standpt				above below standpt
			above below standpt				above below standpt
STANDPOINT:

Mark	Direction	Horiz. Distance	Height Difference
			above below standpt
			above below standpt
Prepared by: *Ruby Cook*

Checked: *Noted on U.T.M. Card*

Sr 2733-1

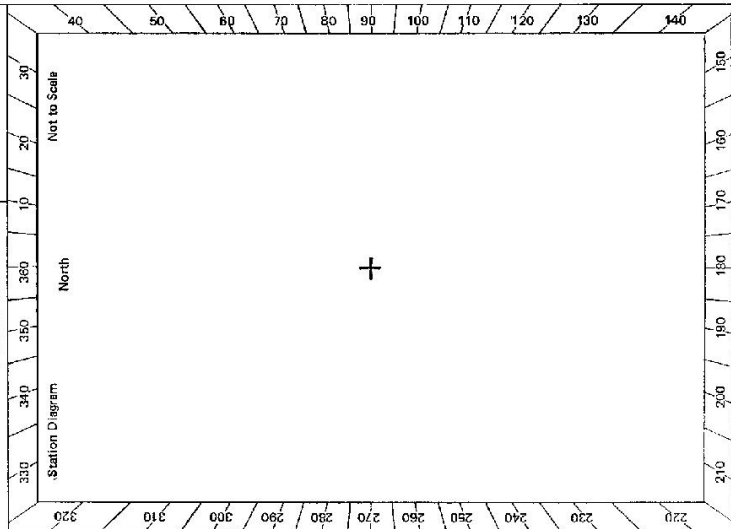


GS

STATION **S.M.A. 1153 TS 35**

Owner's Name: .....  
 Address: *Situated within the KOSUNSKO NATIONAL PARK*  
 Phone: .....  
 Current Occupant: .....  
 Address: .....  
 Phone: .....

**ACCESS**

Access Report of 7.1.79/1979 was found suitable/unsuitable.

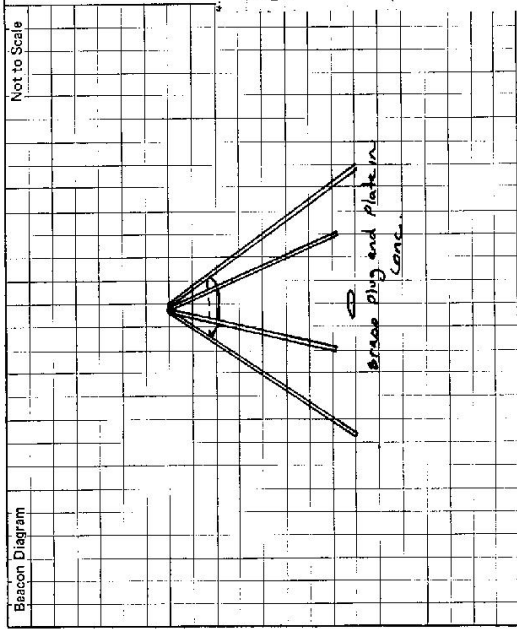

This section to be completed by officer constructing pillar.

Original station mark found/not found.

Description of mark: .....

Original beacon found/not found.


Description of beacon: .....

Height Top of Vanes to Top Mark .....m.

Height of mark .....m. above G.L. below

Diameter of Vanes .....m. Height of Calm .....m.

Original Beacon has/has not been destroyed by me.

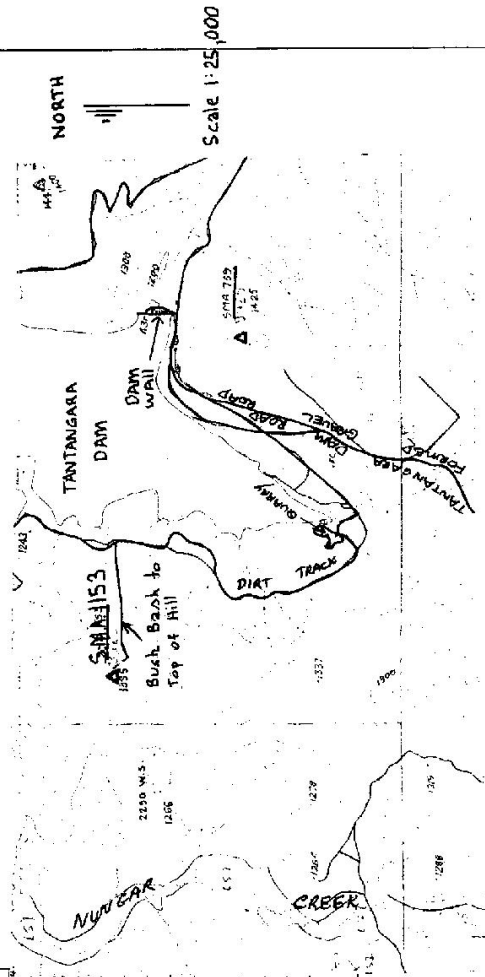

Date	Record of Station
7.3.79	Recommenced construction of T.M. during field completion of Tantangara 1:25,000 Access taken off the Tantangara 1:50,000 traverse.