

CENTRAL MAPPING AUTHORITY

GEODETIC SURVEY OF N.S.W.

GEODETIC STATION RECONNAISSANCE and MAINTENANCE REPORT

Access and Locality Sketch:

STATION MARK:

2. Mark: 6

BEACON:

REFERENCE MARKS:

ACCESS:

Particulars of station marking and beacon:

2" diameter copper tube inserted in top of 5' length of G.I. pipe driven to ground level, with a concrete block marked with the station number around the mark.

Nil.

Three 2" diameter copper tubes in concrete blocks which have been re-inforced with 18" lengths of G.I. pipes beneath the copper tubes. One 2" diameter steel witness post and a red painted shield on a power line pole.

NM/C/69 is in flat, lightly timbered country about 8 miles by road, east of Walgett. It is sited just south of the side track and about 150 yards east of the grid as shown.

Views are a little more than a mile in any direction except north and west along the road. The station is marked with a 12" diameter trench which was dug around the station mark. Pillar

5. A.....set in conc/rock has been placed/found, bearing.....° M from Mast/Plug/Pillar

6. A.....set in conc/rock has been placed/found, bearing.....° M from Mast/Plug/Pillar

7. A.....set in conc/rock has been placed/found, bearing.....° M from Mast/Plug/Pillar

8. Action required:.....

STANDPOINT:

STANDPOINT:

| Mark | Direction | Horiz. Distance | Height Difference | Mark | Direction | Horiz. Distance | Height Difference |
|------|-----------|-----------------|-------------------|------|-----------|-----------------|-------------------|
| | | | above standpt. | | | | above standpt. |
| | | | below | | | | below |
| | | | above standpt. | | | | above standpt. |
| | | | below | | | | below |
Prepared by: D. Fredriksen 26/10/72

Checked:

Checked


St 2733-1

STATION: NM/C/69 No.: 3503

MAP SHEET SCALE 1:250 000 WALGETT

INSPECTED BY: D. FREDRIKSEN DATE: 9/7/79

AUTHORITY: C. M. A. FIELD BOOK:

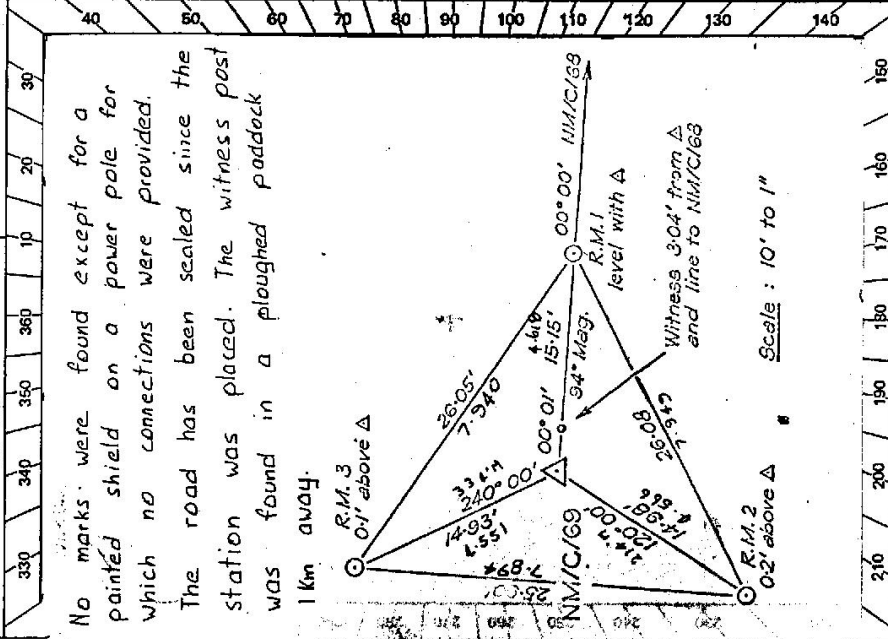

Checked

S: 2733-2 D. West, Government Printer

STATION NM/C/69 TS 3503

| | |
|----------------|--------------|
| Beacon Diagram | Not to Scale |
| | |

This section to be completed by officer constructing pillar.

Original station mark found/not found.

Description of mark:

Original beacon found/not found.


Description of beacon:

Height Top of Vanes to Top Mark.....m.

Height of mark.....m. above rock/conc.....m. above G.L.
below rock/conc.....m. below G.L.

Diameter of Vanesm. Height of Cairnm.

Original Beacon has/has not been destroyed by me.

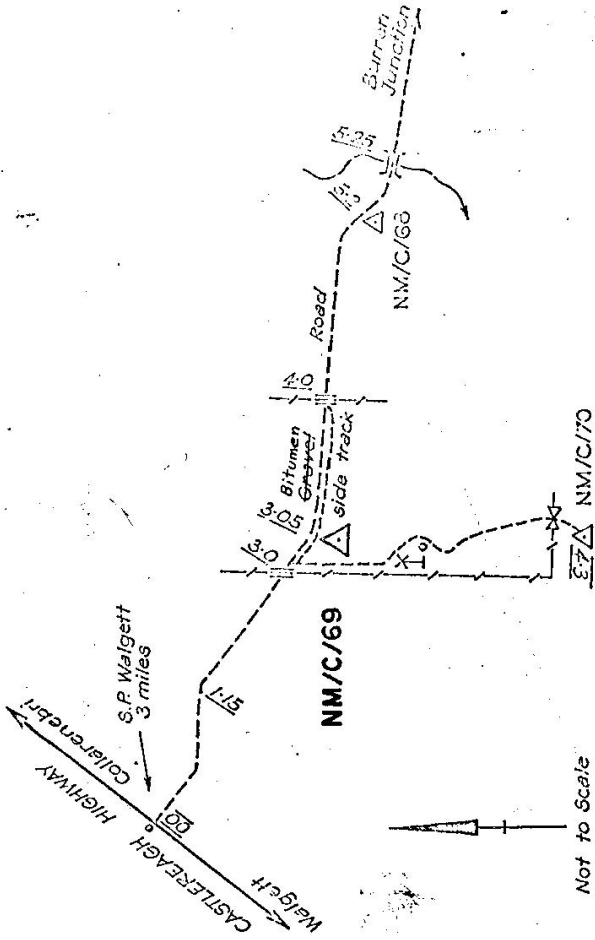

AND WASC 1955

JWV

Date

Record of Station

S: 2733-2 D. West, Government Printer

STATION NM/C/69 TS 3503

| | |
|----------------|--------------|
| Beacon Diagram | Not to Scale |
| | |

This section to be completed by officer constructing pillar.

Original station mark found/not found.

Description of mark:

Original beacon found/not found.


Description of beacon:

Height Top of Vanes to Top Mark.....m.

Height of mark.....m. above rock/conc.....m. above G.L.
below rock/conc.....m. below G.L.

Diameter of Vanesm. Height of Cairnm.

Original Beacon has/has not been destroyed by me.

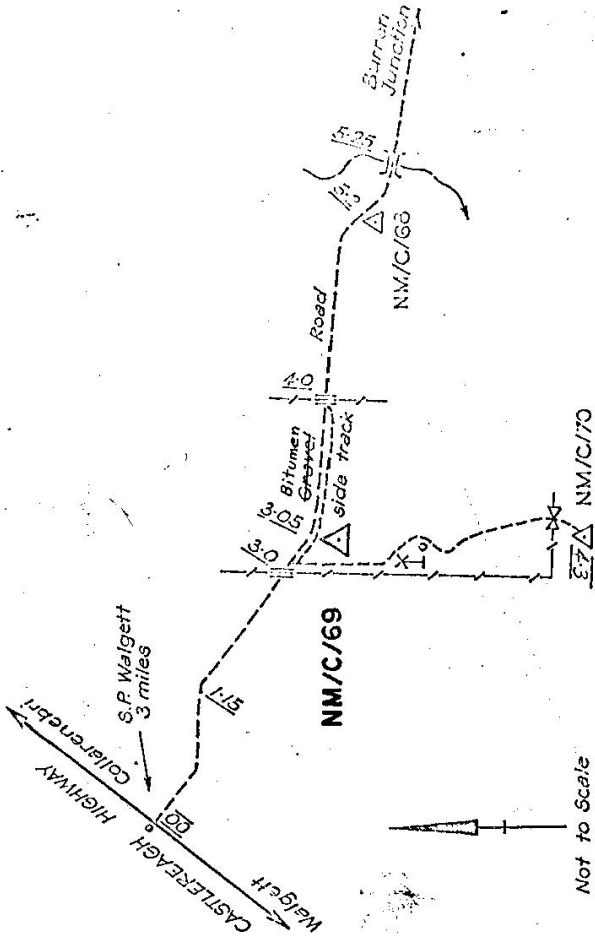

AND WASC 1955

JWV

| | |
|------|-------------------|
| Date | Record of Station |
| | |
| | |
