

CENTRAL MAPPING AUTHORITY

GEODETTIC SURVEY OF N.S.W.

GEODETTIC STATION RECONNAISSANCE and MAINTENANCE REPORT

Access and Locality Sketch:

STATION MARK: 1/2" diameter copper tube inserted in top of 18" length of 1/2" G.I. pipe. This is set in a concrete block marked with the station number.

BEACON: Nil.

REFERENCE MARKS: Three 3/4" diameter copper tubes in concrete blocks which have been re-inforced with 18" steel pickets. One steel witness post, and a blazed eucalypt with the blaze painted red.


ACCESS: Station NM/C/70 was sited on the north bank of the Namoi River to see through a small gap in the 50' high trees along the river. It is on flat ground and visibility is restricted to about 1 mile through the scattered trees, north to the road, and 1 1/2 miles through the small gap, to the south. Easy approach as shown. A 12" diameter trench has been dug around the station mark.

- 4. A.....M from Mast/Plug/Pillar
- 5. A.....M from Mast/Plug/Pillar
- 6. A.....M from Mast/Plug/Pillar
- 7. A.....M from Mast/Plug/Pillar
- 8. Action required:.....

STANDPOINT:							
Mark	Direction	Horiz. Distance	Height Difference	Mark	Direction	Horiz. Distance	Height Difference
			above standpt				above standpt
			below standpt				below standpt
			above standpt				above standpt
			below standpt				below standpt
Prepared by: D. Fredriksen 26/10/19 Noted on U.T.M. Card

Sr 2733-1

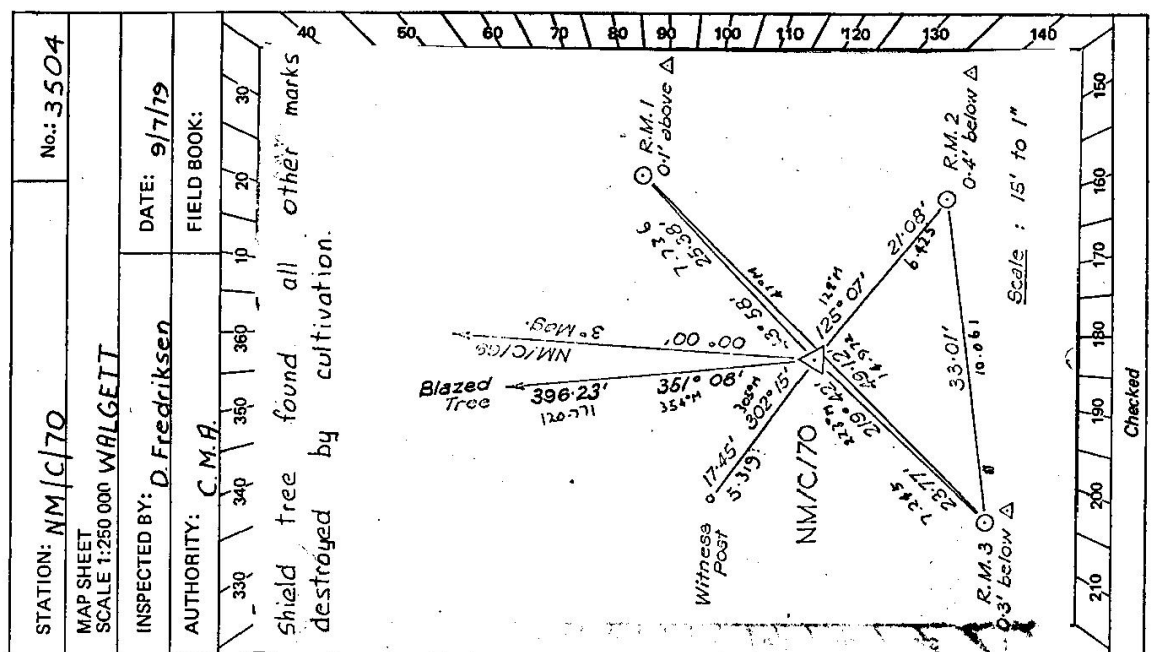


Shield tree found all other marks destroyed by cultivation.

Checked

St 2733-2 D. West, Government Printer

STATION NM/C/70 TS 3504

Beacon Diagram	Not to Scale

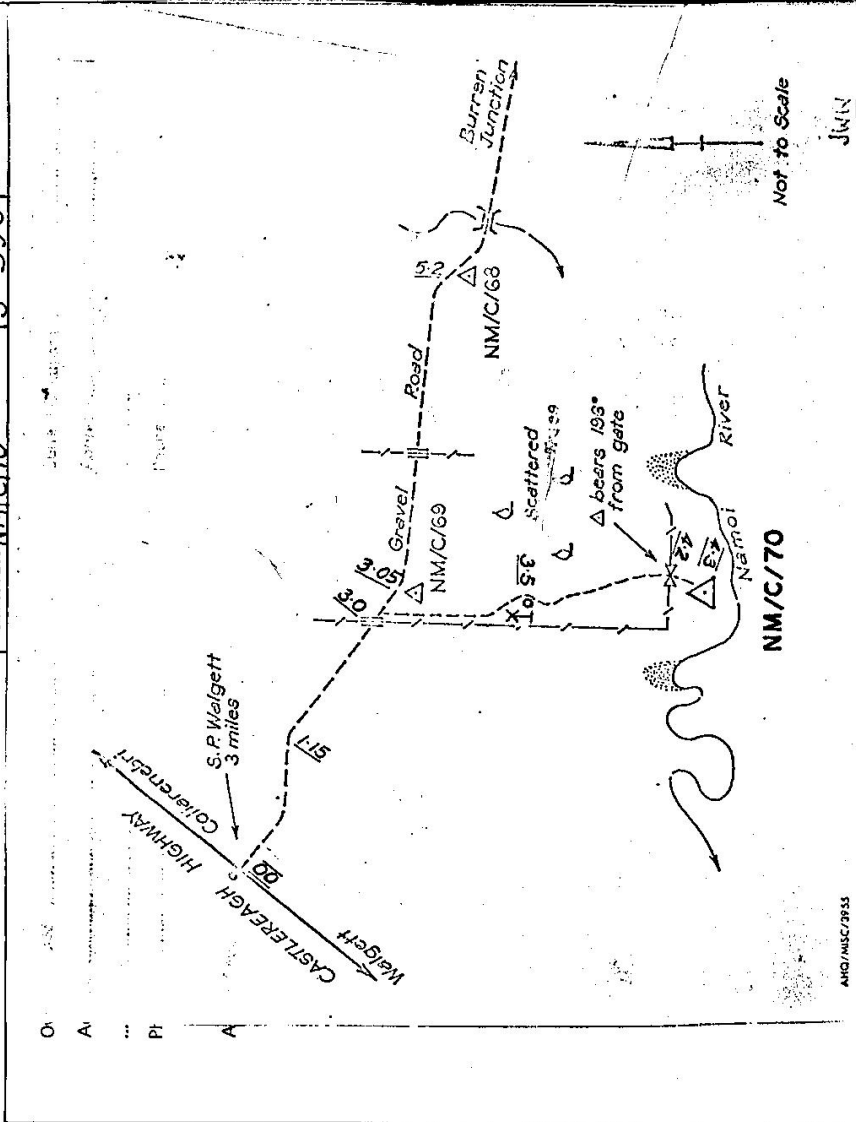

Date	Record of Station

This section to be completed by officer constructing pillar.

Original station mark found/not found.

Description of mark:

Original beacon found/not found.

Description of beacon:

Height Top of Vanes to Top Mark.....m.

Height of mark.....m. above rock/conc.....m. below G.L.

Diameter of Vanesm. Height of Cairnm.

Original Beacon has/has not been destroyed by me.