

CENTRAL MAPPING AUTHORITY

GEODETIC SURVEY OF N.S.W.

GEODETIC STATION RECONNAISSANCE and MAINTENANCE REPORT

Access and Locality Sketch:

STATION MARK: 1/2" diameter copper tube inserted in top of a 4' length of Mast G.I. pipe which was driven into the ground. This is set in a concrete block marked with the station number.

Particulars of station marking and beacon:

BEACON: Nil.

REFERENCE MARKS:

Three 1/2" copper tubes inserted in 24" lengths of G.I. pipe driven to G.L. These are set in concrete blocks. One Steel Witness Post and one blaze on a tree painted red.

ACCESS:

NM/C/71 is in a flat, lightly timbered paddock, about 4 miles east of Walgett. It is sited to look through a gap in the high trees along the banks of the Namoi River and directly along the road to NM/C/72 on the eastern outskirts of Walgett. A 10' tower was used for observations and measurements. A 12' diameter trench was dug around the station mark. The owner reports that this paddock, less the area around the station mark, may soon be cultivated.

- 6. A set in conc/rock has been placed/found, bearing.....° M from Mast/Plug/Pillar
- 7. A set in conc/rock has been placed/found, bearing.....° M from Mast/Plug/Pillar
- 8. Action required:.....

STANDPOINT:				STANDPOINT:			
Mark	Direction	Horiz. Distance	Height Difference	Mark	Direction	Horiz. Distance	Height
			above standpt.				
			below standpt.				
			above standpt.				
			below standpt.				
			above standpt.				
			below standpt.				
			above standpt.				
			below standpt.				

Prepared by: D. Fredrikson 26/10/79 Checked: Noted on U.T.M. Card


St 2733-1

STATION: NM/C/71 No.: 3505

MAP SHEET SCALE 1:250 000 WALGETT

INSPECTED BY: D. FREDRIKSEN DATE: 9/7/79

AUTHORITY: C.M.A. FIELD BOOK:

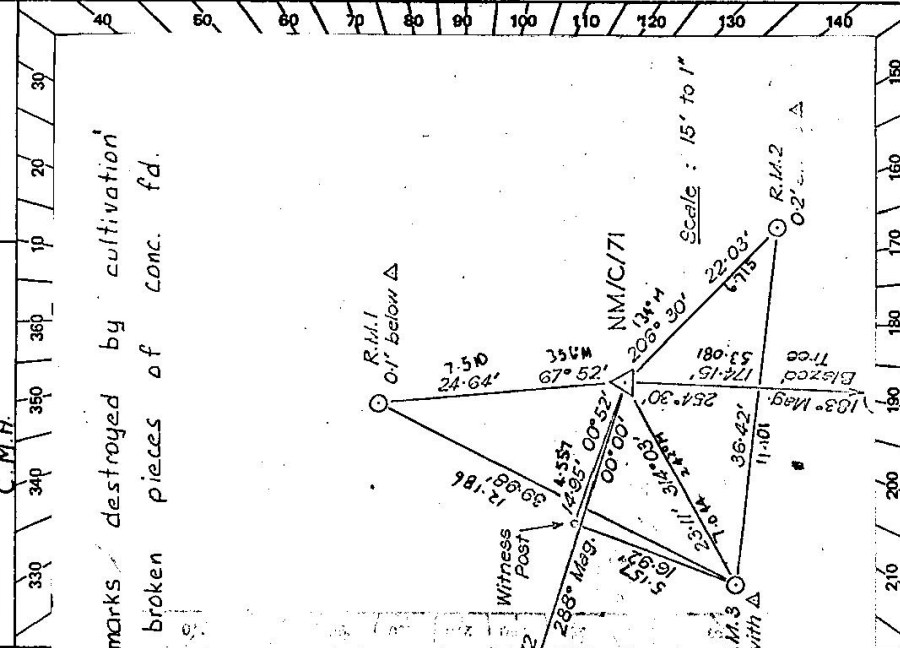

All marks destroyed by cultivation only broken pieces of conc. fd.

Checked

ST 2733-2 D. West, Government Printer	STATION NM/C/71 TS 3505		Record of Station
Beacon Diagram	Not to Scale	This section to be completed by officer constructing pillar. Original station mark found/not found. Description of mark: Original beacon found/not found. Description of beacon: Height Top of Vanes to Top Markm. Height of markm. above G.L. below rock/concm. below Diameter of Vanesm. Height of Cairnm. Original Beacon has/has not been destroyed by me.	Date