

CENTRAL MAPPING AUTHORITY

GEODETTIC SURVEY OF N.S.W.

GEODETTIC STATION RECONNAISSANCE and MAINTENANCE REPORT

Access and Locality Sketch:

Particulars of station marking and beacon which do not apply
 1/2" diameter copper tube inscribed in a 5" length of G.I. pipe. It
 which has been driven to G.L. This has been set in a
 concrete block marked with the station number.

BEACON: Nil.

REFERENCE MARKS:
 Three 1/2" diameter copper tubes set in the top of 18" lengths of
 of G.I. pipe. These are in concrete blocks. One steel
 Witness Post on line to NM/C/71.

ACCESS:
 NM/C/72 is sited on top of the Levee bank at the eastern
 edge of the Walgett Township. It is just past the end of
 Turossa Street, and is sited to look westward down the
 street, and eastward down the Pilliga road. Views are
 restricted in all other directions except S & S.E. across
 the aerodrome. As the station is on top of a narrow levee
 bank the steel witness post is the only distinctive mark.

5. A.....set in conc/rock has been placed/ found, bearing.....° M from Mast/Plug/Pillar
6. A.....set in conc/rock has been placed/ found, bearing.....° M from Mast/Plug/Pillar
7. A.....set in conc/rock has been placed/ found, bearing.....° M from Mast/Plug/Pillar


8. Action required:.....

STANDPOINT:				STANDPOINT:			
Mark	Direction	Horiz. Distance	Height Difference	Mark	Direction	Horiz. Distance	Height Difference
			above standpt.				above standpt.
			below				below
			above standpt.				above
			below				below
			above standpt.				above
			below				below
			above standpt.				above
			below				below

Prepared by: D. FREDRIKSEN 30/10/79 Checked: Noted on U.T.M. Card

STATION: NM/C/72 No.: 3506
 MAP SHEET SCALE 1:250 000 WALGETT
 INSPECTED BY: D. FREDRIKSEN DATE: 9/7/79
 AUTHORITY: C. M. A. FIELD BOOK:

No marks found; assumed to have been destroyed by work on levee bank.

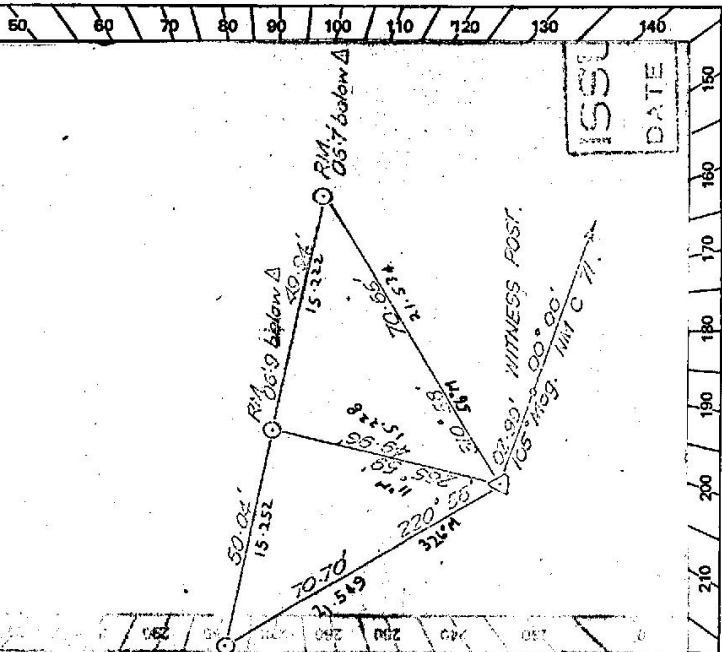

ISSUED DATE

