





CENTRAL MAPPING AUTHORITY

GEODETIC SURVEY OF N.S.W.

GEODETIC STATION RECONNAISSANCE and MAINTENANCE REPORT

Description:

1. ~~Cleared by lanes bearing~~ *Note: Cross out word or words which do not apply*  
 from ~~High-Mast~~

2. ~~Mast & Vanes have been pointed white & black respectively.~~

3. ~~The station/pillar was unplaced/not unplaced/constructed on~~ *10* dimensions ~~now being~~

Description of mark: ~~Copper plate in concrete~~ be explicit, e.g. S/Steel Pillar Plate, Steel plug, Brass plug, Bolt, G.I. Pipe

Height of mark: ~~0.0~~ m. <sup>above</sup> ~~0.15~~ m. <sub>below</sub> G.L.

Height of Top Vanes to Top Mark/Pillar plate: ~~m.~~ Diameter of Vanes (vertical) ~~m.~~

Height of Cairn: ~~m.~~ Diameter of Cairn: ~~m.~~ Name Plate found/not found/placed

Length of Mast: ~~m.~~ (approximate if not unplaced)

4. A ~~gal. iron~~ witness post in conc. was found/bearing ~~330°~~ <sup>0°</sup> M from Mast/Plug/Pillar

5. A ~~set in conc./rock~~ has been placed/found, bearing ~~330°~~ <sup>330°</sup> M from Mast/Plug/Pillar

6. A ~~set in conc./rock~~ has been placed/found, bearing ~~0°~~ <sup>0°</sup> M from Mast/Plug/Pillar

7. A ~~set in conc./rock~~ has been placed/found, bearing ~~0°~~ <sup>0°</sup> M from Mast/Plug/Pillar

8. Action required: ~~N.M.C. 1073 will need to be checked. 3 m. towers. m. g. has. needed~~  
 for observations


STANDPOINT:

Mark	Direction	Horiz. Distance	Height Difference	Mark	Direction	Horiz. Distance	Height Difference
			above standpt.				above standpt.
			below				below
			above standpt.				above standpt.
			below				below
Prepared by: *[Signature]* 4.3.81 Checked: *[Signature]*

SR 2733-1

Noted on U.T.M. Card

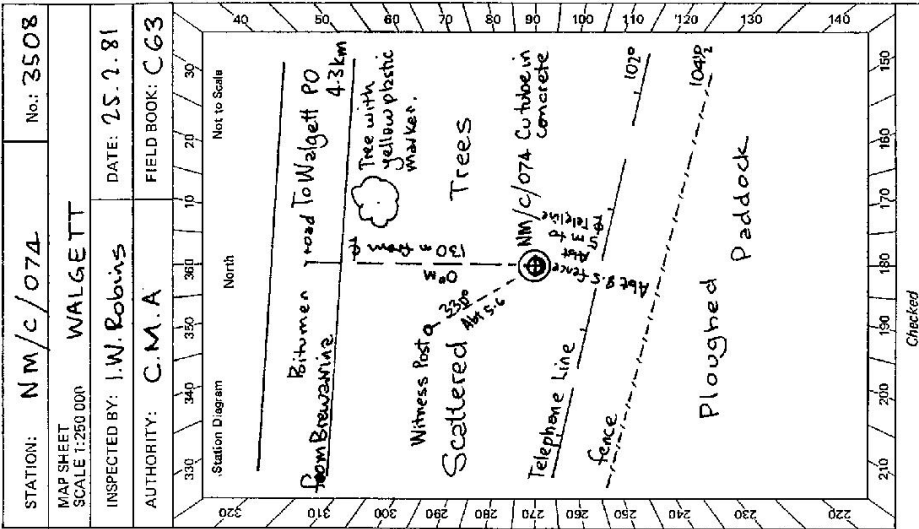

Checked

8. 2735-2 D. West. Government Printer

STATION **NM/C/074** IS **3508**

Owner's Name: **Public Road** Current Occupant: .....

Address: ..... Address: .....

Phone: ..... Phone: **25-2-1981**

**ACCESS** **25-2-1981**

**Access Report of form 10/19-1981 was found suitable for installation.**

**0.0** **Walgett Post Office; Head west along Wee Wee St towards Brewarrina**

**4.3** **At tree on left with yellow plastic marker turn left off road & head 180° Mag. for 130m.**

**4.4** **NM/C/074 Cu tube in concrete about 8.5 m from fence.**

km

Not to Scale

This section to be completed by officer constructing pillar.

Original station mark found/not found.

Description of mark: .....

Original beacon found/not found.

Description of beacon: .....

Height Top of Vanes to Top Mark.....m.

Height of mark.....m above G.L. below

Diameter of Vanes.....m Height of Cairn.....m.

Original Beacon has/has not been destroyed by me.

Date

Record of Station