


2733-2 D. West, Government Printer

STATION NM | C | 91 TS 3521

Beacon Diagram	Not to Scale

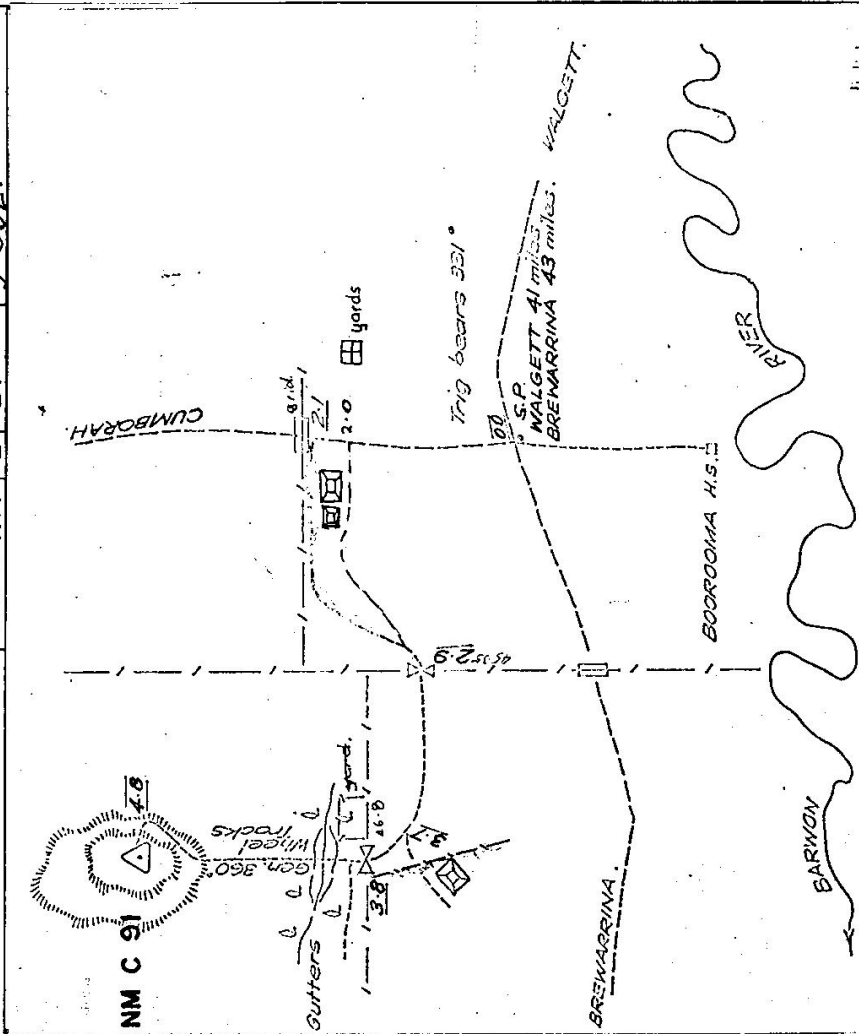

Date	Record of Station	JW

This section to be completed by officer constructing pillar.

Original station mark found/not found.

Description of mark:

Original beacon found/not found.

Description of beacon:

Height Top of Vanes to Top Mark.....m.

Height of mark.....m. above rock/conc.....m. below G.L.

Diameter of Vanes.....m.

Height of Cairn.....m.

Original Beacon has/has not been destroyed by me.