



TS353

TS353 CMA 3-084

Locality : Wilcannia

LGA : Central Darling

STATION CMA 3 - 084

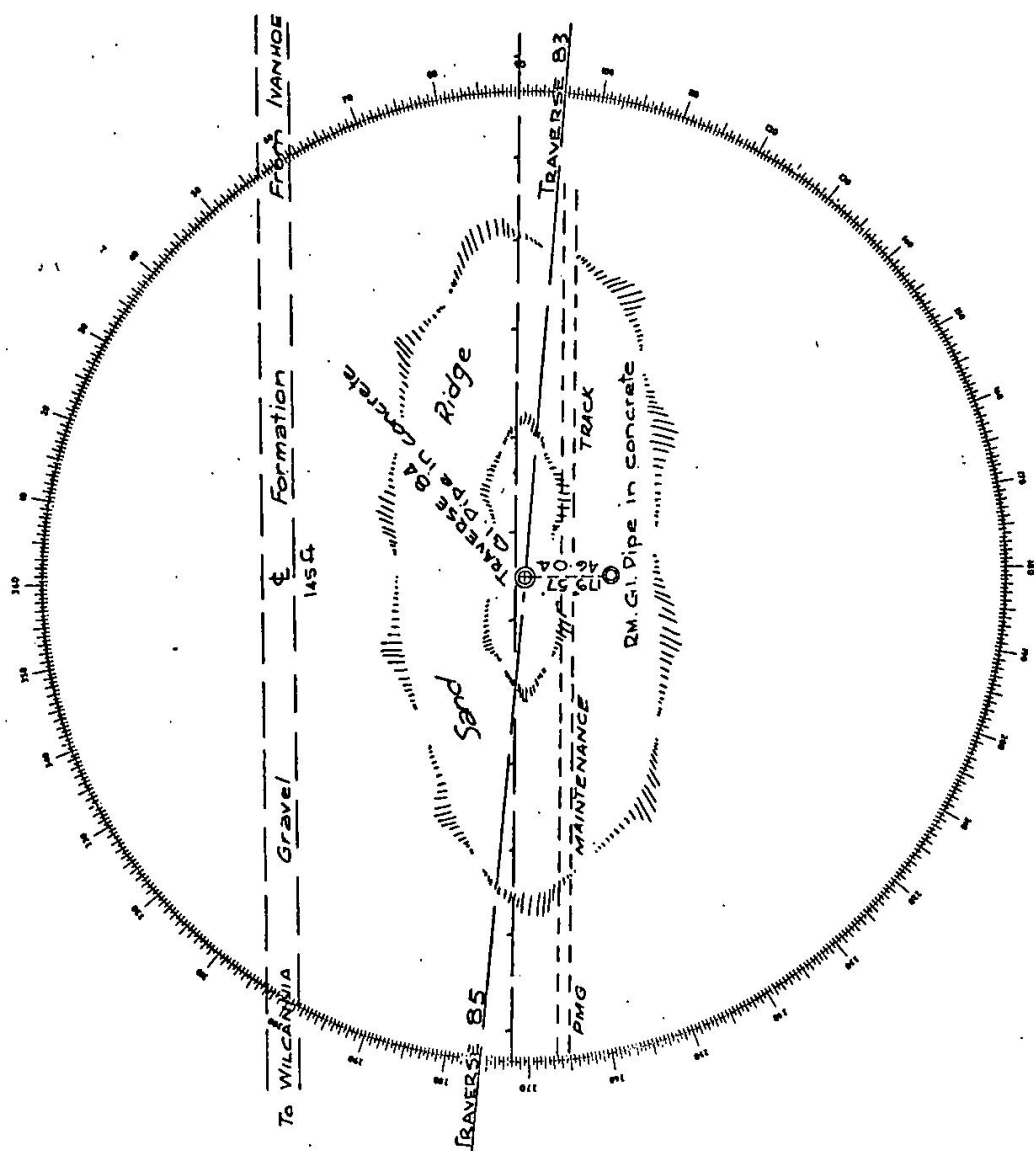


Photo by Wilcannia