

CENTRAL MAPPING AUTHORITY  
Department of Lands

Trigonometrical Survey of N.S.W.

RECONNAISSANCE and MAINTENANCE REPORT

This Trig. Station has been:-

Note: Cross out word or words which do not apply

1. Completely cleared to permit 360° vision to surrounding Trigs.
2. Cleared by lances bearing ..... from Trig. Mast
3. Trig. Mast & Vanes have been painted white & black respectively.
4. The Trig. was unpiled/not unpiled, dimensions now being: .....

Description of mark ..... should be explicit, e.g. Steel plug, Brass plug, Bolt, G.I. Pipe  
 Height of mark ..... m above rock/concrete ..... m above G.L.  
 Height of Top Vanes to Top Mark ..... m. Diameter of Vanes (vertical) 0.76 m.  
 Height of Cairn 1.20 m. Diameter of Cairn 1.50 m.  
 Length of Mast 3.20 m. (approximate if not unpiled)

5. A ..... set in conc/rock has been placed ..... m. bearing ..... °M. from Trig. Mast
6. A ..... set in conc/soil has been placed ..... m. bearing ..... °M. from Trig. Mast
7. A ..... set in conc/soil has been placed ..... m. bearing ..... °M. from Trig. Mast
8. A ..... set in conc/rock has been placed ..... m. bearing ..... °M. from Trig. Mast
9. Connection to ..... m. bearing ..... °M
10. Connection to ..... m. bearing ..... °M
11. Connection to ..... m. bearing ..... °M
12. Connection to ..... m. bearing ..... °M
13. Diff. Ht. is ..... m. above below
14. Diff. Ht. is ..... m. above below
15. Diff. Ht. is ..... m. above below
16. Diff. Ht. is ..... m. above below

Prepared by: M.L. Morrison Checked: \_\_\_\_\_

Noted on U.T.M. Card

STATION NOBBY

TS 3534

Co: VERLON

Ph: KANGAROO FLAT

Map Sheet: COWARRAL

No: 9335

Inspected by: M.L. MORRISON


Date: 16 AUGUST 1977

Authority:

Field Book: 1581

Beacon Diagram

Not to Scale

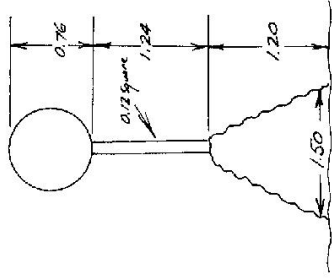

Date

Record of Station

TRIG. FD IN FAIR CONDITION NEEDS NEW  
MAST. (BETTER) VANES OK. NOT 2 DAYS CLEARING  
REQUIRED FOR 360° VISION

Checked

