

IS


STATION **NAROOMA G.S. 3542**

Owner's Name: **T.R. ZFOIA** Current Occupant:
 Address: **NOWRA L.B.O.** Address:
 Phone: Phone:

ACCESS

Access Report of 25/3/1981 was found suitable/unsuitable.

- 0.00 NAROOMA P.O. SOUTH ALONG H.W.Y. TOWARDS BEGA
- 6.55 TURN LEFT (FIRE TRACK) HEAD EAST ON MAIN TRACK
- 6.68 OLD GRID
- 7.32 PASS TRACK ON R.H.S. STAYING ON MAIN TRACK
- 7.93 FOLLOW. ALONG FENCE THEN ROUND TO RIGHT
- 8.48 NAROOMA GEODETIC STATION

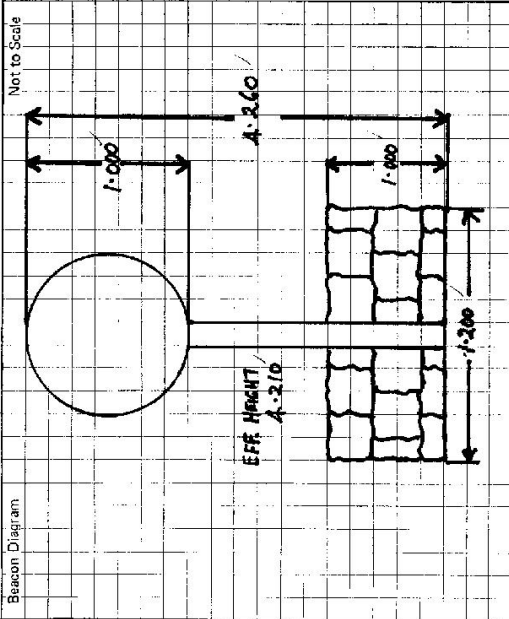

This section to be completed by officer constructing pillar.

Original station mark found/not found.

Description of mark:

Original beacon found/not found.

Description of beacon:

Height Top of Vanes to Top Mark:m.

Height of mark:m. above G.L. below

Diameter of Vanes:m.

Original Beacon has/has not been destroyed by me. Height of Cairn:m.

Date

Record of Station

CENTRAL MAPPING AUTHORITY

GEODETIC SURVEY OF A.S.W.

GEODETIC STATION RECONNAISSANCE and MAINTENANCE REPORT

Description: Cleared by lanes bearing 350° ^{20'} _{20'} Note: Cross out word or words which do not apply

1. Mast & Vanes have been painted white & black respectively. from Trig. Mast

2. The station ~~marker~~ was unspilled/~~replaced~~/constructed on $15/177$ ^{18.81} _{18.81} dimensions now being:

Description of mark: Brass Plug should be explicit, e.g., S/Steel Pillar Plate, Steel plug, Brass plug, Bolt, G.I. Pipe

Height of mark: 0.027 ^{above} _{below} rock/~~concrete~~ Mark is 0.2 ^{above} _{below} G.L.

Height of Top Vanes to Top Mark/~~Pillar plate~~ 4.248 m. Diameter of Vanes (vertical) 1.015 m.

Height of Cairn 1.1 m. Diameter of Cairn 1.9 m. Name Plate found/not found/placed.

Length of Mast 4.275 m. (approximate if not unspilled)

4. A G.I. Pipe set in conc/~~rock~~ has been ~~placed~~/found, bearing 181° M from Mast/Plug/Pillar

5. A G.I. Pipe set in conc/~~rock~~ has been placed/~~found~~, bearing 235° M from Mast/Plug/Pillar

6. AN SSM set in conc/~~rock~~ has been ~~placed~~/found, bearing 246° M from Mast/Plug/Pillar

7. A set in conc/~~rock~~ has been placed/~~found~~, bearing 246° M from Mast/Plug/Pillar


8. Action required: Clearing of scrub around Cairn

STANDPOINT: Trig Plug


Mark	Direction	Horiz. Distance	Height Difference	Mark	Direction	Horiz. Distance	Height Difference
DREGEZARV G.S.	0 00 00		above standpt				above standpt
SSM in conc	11 20 05	3.614	below standpt				below standpt
Light House (wood)	01 17 10		above standpt				above standpt
G.I. Pipe in Conc	305 09 50	5.359	below standpt				below standpt
G.I. Pipe in Soil	0 00 10	5.650	below standpt				below standpt

Prepared by: *[Signature]* Checked: *[Signature]* Noted on U.T.M. Card

SR 2733-1

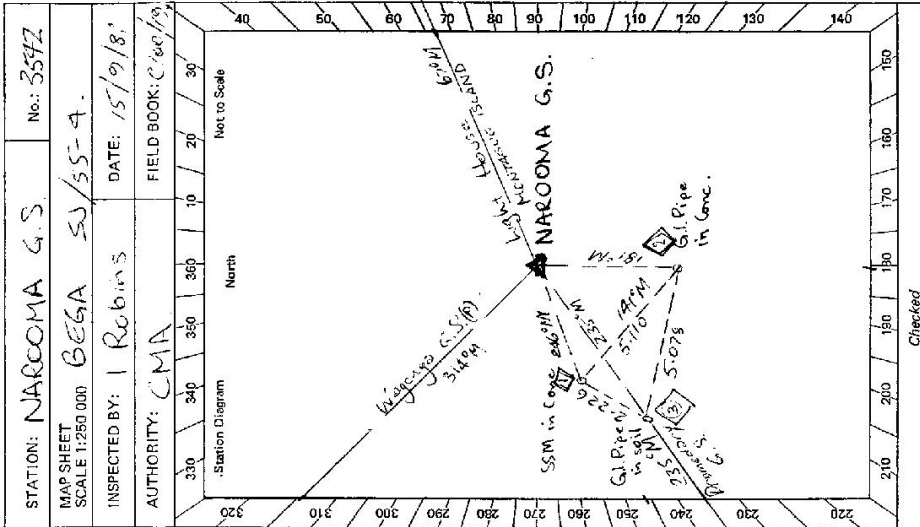

Checked

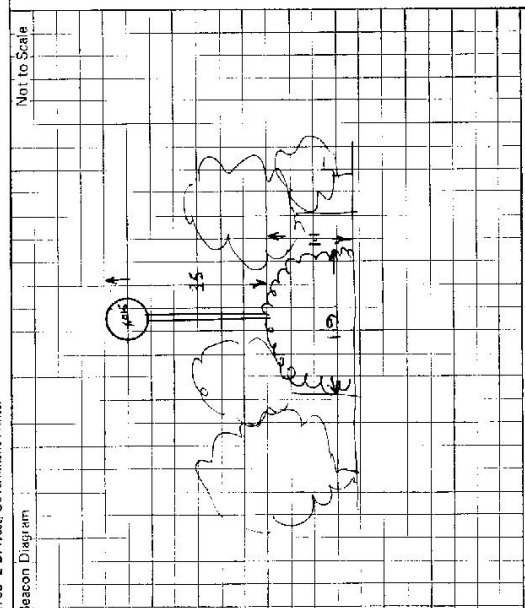STATION NAROCMA G.S. TS 3542	Owner's Name: Address: Phone: Current Occupant: Address: Phone: ACCESS Access Report of/19..... was found subject to the same ^{NCT}
Beacon Diagram Not to Scale	
This section to be completed by officer constructing pillar.	
Original station mark found/not found.	
Description of mark: BRASS Plug in rock.	
Original beacon found/not found.	
Description of beacon: MAST & VANES in CAIRN	
Height Top of Vanes to Top Markm.	
Height of markm. above rock/conc.m. above G.L. belowm. belowm.	
Diameter of Vanesm. Height of Cairnm.	
Original Beacon has/has not been destroyed by me.	
Date 15/12/81	Record of Station Spatkin & Robins

CENTRAL MAPPING AUTHORITY

GEODETIC SURVEY OF N.S.W.

GEODETIC STATION RECONNAISSANCE and MAINTENANCE REPORT

Description:

1. Cleared by lanes bearing 360 M *Note: Cross out word or words which do not apply* from Trig. Mast
2. Mast & Vanes have been painted white & black respectively.
3. The station ~~marker~~ was unpiled/~~removed~~/replaced on 4th Dec 1984, dimensions now being:
Description of mark Brass Pipe should be explicit, e.g., S/Steel Pillar Plate, Steel plug, Brass plug, Bolt, G.I. Pipe
Height of mark 0.035 m. ^{above}/_{below} rock/~~concrete~~; Mark is UNFILED ^{above}/_{below} G.L.
Height of Top Vanes to Top Mark/~~Plate~~ 0.240 m. Diameter of Vanes (vertical) 191.5 m.
Height of Cairn 0.800 m. Diameter of Cairn 120 m. Name Plate ~~found~~/not found/placed.
Length of Mast 0.275 m. (approximate if not unpiled)
4. A. C.I. Pipe set in conc/rock has been ~~placed~~/found, bearing 180 °M from ~~mark~~/Plug/~~marker~~
5. A. S.S. M set in conc/rock has been ~~placed~~/found, bearing 241 °M from ~~mark~~/Plug/~~marker~~
6. A. set in conc/rock has been placed/found, bearing °M from Mast/Plug/Pillar
7. A. set in conc/rock has been placed/found, bearing °M from Mast/Plug/Pillar
8. Action required: PLACE CONCRETE OBSERVING PILLAR

STANDPOINT:

STANDPOINT:

Mark	Direction	Horiz. Distance	Height Difference	Mark	Direction	Horiz. Distance	Height Difference
			above standpt. below				above standpt. below
			above standpt. below				above standpt. below
Prepared by: P. Berts

20.12.84

Checked: AS

16/1/85

Noted on U.T.M. Card 14

Checked 1973 5.12.83

STATION: NARROMA G.S. No.: 3542
 MAP SHEETS BEGA SCALE 1:250 000
 SCALE 1:100 000
 INSPECTED BY: P. Berts DATE: 14.12.84
 AUTHORITY: C.M.A. FIELD BOOK: 1947

Station Diagram

Not to Scale

SI 2733-2 D. West, Government Printer


STATION NAROOMA TS 3542

Owner's Name: TR 25012 Current Occupant:
 Address: MOYRA LEO Address:
 Phone: Phone:

ACCESS

Access Report of 11/12/1984 was found suitable/unavailable.

KEY
 000 POST OFFICE NAROOMA HEADS INTO ALONG PACIFIC HIGHWAY
 468 BRIDGE OVER NAUGUSEA LAKE
 632 TURN LEFT OFF HIGHWAY AT CORNER OF HILL
 6-37 POST TRUCK ON LEFT
 6-45 OLD WOODEN BRIDGE
 707 POST TRUCK ON RIGHT
 7-34 POST TRUCK ON LEFT - VERY FAINT
 7-54 POST TRUCK ON RIGHT
 7-83 POST TRUCK ON RIGHT
 7-99 POST TRUCK AWAY FROM FENCE
 8-21 NAROOMA ST.

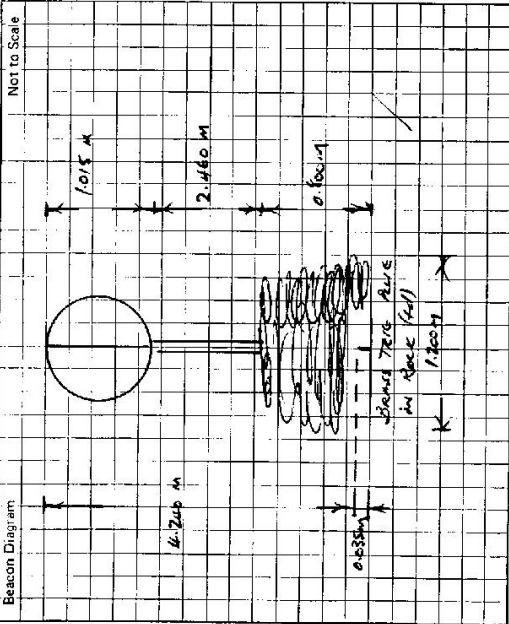

This section to be completed by officer constructing pillar.

Original station mark found/not found.

Description of mark:

Original beacon found/not found.

Description of beacon:

Height Top of Vanes to Top Markm.

Height of markm. above G.L. below G.L.

Diameter of Vanesm. Height of Cairnm.

Original Beacon has/has not been destroyed by me.

Date

Record of Station