


2 of 2

GEODETIC STATION RECONNAISSANCE and MAINTENANCE REPORT

STATION: **NORTH BARRIER GS** TS No.: **3547**
 MAP SHEETS SCALE 1:250 000 **BROKEN HILL** SCALE 1:100 000 **CORONA**
 INSPECTED BY: **G. L. FORD** DATE: **14-3-90**
 AUTHORITY: **L. I. C.** FIELD BOOK: **C606**

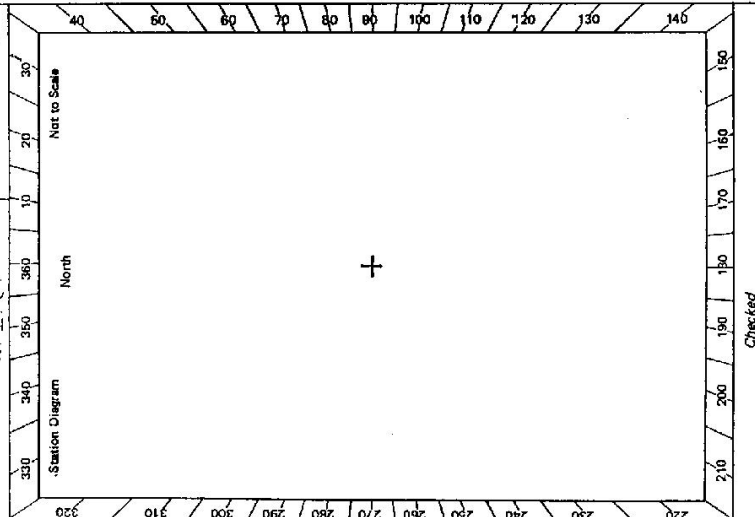

STANDPOINT: G. I. PIPE				STANDPOINT: STAR PICKET ①			
Mark	Direction	Horiz. Distance	Height Difference	Mark	Direction	Horiz. Distance	Height Difference
RD	0 00 00	1	above standpt.	AG	0 00 00	1	above standpt.
STAR PICKET ①	240 44	20 16 195	above standpt.	TRIG PILE	8 35	20 13 334	above standpt.
TRIG PILE	272 25	20 14 539	above standpt.	G. I. PIPE	54 14	00 16 192	above standpt.
G. I. NHIL ①	272 25	30 12 239	above standpt.	STAR PICKET ②	330 07	00 14 185	above standpt.
STAR PICKET ②	277 42	50 16 855	above standpt.	STAR PICKET ③	357 57	40 16 851	above standpt.
STAR PICKET ③	307 58	20 16 180	above standpt.				

STANDPOINT:				STANDPOINT:			
Mark	Direction	Horiz. Distance	Height Difference	Mark	Direction	Horiz. Distance	Height Difference
			above standpt.				above standpt.
			below standpt.				below standpt.
			above standpt.				above standpt.
			below standpt.				below standpt.
			above standpt.				above standpt.
			below standpt.				below standpt.
			above standpt.				above standpt.
			below standpt.				below standpt.

Prepared by: **[Signature]** Checked: **[Signature]** 2/11/90 *Noted on U.T.M. Card*

GS 24

STATION <u>NORTH BARRIER (P) IS 3547</u>	Current Occupant: Address: Phone: Owner's Name <u>M. GLEN COLLEN</u> Address <u>F.L.O.R.D.S. CREEK</u> <u>VIA BARKEN HILL</u> <u>FOWKER CREEK RD.</u> Access Report of <u>21/12/89</u> was found suitable/unsuitable. SEE D. J. KAIN ACCESS <u>12/12/89</u> ACCESS:
Beacon Diagram Not to Scale	
This section to be completed by officer constructing pillar.	
Original station mark found/not found.	
Description of mark: <u>SEE D. J. KAIN STATION CARD 12/12/89</u>	
Original beacon found/not found.	
Description of beacon:	
Height Top of Vanes to Top Mark m.	
Height of mark m. above G.L.	
Diameter of Vanes m.	
Original Beacon has/has not been destroyed by me.	
Date	Record of Station

GEODETTIC STATION RECONNAISSANCE and MAINTENANCE REPORT

2 of 2 STATION: **NORTH BARKER (P)** No.: **3547**
 MAP SHEETS SCALE 1:250 000 **BARKER HILL**
 SCALE 1:100 000 **CDRONA**
 INSPECTED BY: **C. I. Ford** DATE: **17-3-90**
 AUTHORITY: **L. I. C.** FIELD BOOK: **C 606**

Station Diagram

STANDPOINT: STAR PICKET ①				STANDPOINT: STAR PICKET ②			
Mark	Direction	Horiz. Distance	Height Difference	Mark	Direction	Horiz. Distance	Height Difference
RO	0 00 00 1		above standpt. below	RO	0 00 00 1		above standpt. below
G.I. PIPER ④	121 08 05 16	178 40 482	above standpt. below	PILLAR	8 3 4 20 13 333 1633		above standpt. below
PILLAR	167 52 15 13	628 1 550	above standpt. below				above standpt. below
STAR PICKET ①	177 37 25 16	852 10 081	above standpt. below				above standpt. below
STAR PICKET ②	206 51 15 13	466 10 026	above standpt. below				above standpt. below
G.I. MARK ③	167 52 55 11	329 10 016	above standpt. below				above standpt. below

STATION DIAGRAM

STANDPOINT: STAR PICKET ③				STANDPOINT: STAR PICKET ④			
Mark	Direction	Horiz. Distance	Height Difference	Mark	Direction	Horiz. Distance	Height Difference
			above standpt. below				above standpt. below
			above standpt. below				above standpt. below
Station Diagram

Not to Scale

North

+

Checked

Prepared by: _____

Checked by: _____

Noted on U.T.M. Card



