

Co: CUMBERLAND  
 Map Sheet: PYMBLE  
 Inspected by: C. Jeremy  
 Authority: LANDS (Integration)  
 No: UO960  
 Date: Oct 1973  
 Field Book: CS 216

Beacon Diagram  
 Not to Scale  
 Subsurface mark - no vanes or above-ground structure.  
 Cover box with plate marked "NORTH S"

This Trig. Station has been:-  
 Note: Cross out word or words which do not apply

1. Completely cleared to permit 360° vision to surrounding trig.
2. Cleared by James bearing from Trig. West
3. Trig. West & Vanes have been painted white & black respectively. <sup>4.1</sup> under PM box
4. The Trig. was unpecked/ret-unpecked, dimensions now being:

Description of mark: Stainless steel pin in conc. should be explicit, e.g. Steel plug, Brass plug, Bolt, Concrete Pillar  
 Height of mark: 0.02 m above rock/concrete 0.41 m above G.L.  
 Height of Top Vanes to Top Mark/Top pillar plate:          m Diameter of Vanes (vertical):          m  
 Height of Coin:          m Diameter of Coin:          m

Length of West:          m (approximate if not unpecked)

5. A PH & W(1) set in conc/rock has been placed/d 6.07 m bearing 2.68 °M from Trig. West/pillar
6. A PH & W(2) set in conc/rock has been placed/d 6.95 m bearing 2.96 °M from Trig. West/pillar
7. A PH & W(3) set in conc/rock has been placed/d 10.84 m bearing 2.11 °M from Trig. West/pillar
8. A corner set in conc/rock has been placed/d 11.2 m bearing 6.8 °M from Trig. West/pillar

9. Connection: I.S. to PH(1): 6.072 m bearing 2.68 °M
10. Connection: I.S. to Bolt: 16.209 m bearing 2.60 °M
11. Connection: I.S. to PM 16322: 327.63 m bearing 35.6 °M
12. Connection:          to         :          m bearing          °M

13. Diff. Ht. I.S. pin is 0.33 m <sup>above</sup> PH & W(1)
14. Diff. Ht. I.S. pin is 0.10 m <sup>above</sup> Bolt in bitumen
15. Diff. Ht.          is          m <sup>above</sup>
16. Diff. Ht.          is          m <sup>above</sup>

Prepared by: C. Jeremy Checked: D.V.

Date	Record of Station
5/60	Original mark destroyed
1968	Stainless steel pin placed in conc. underground

STATION TS 3553 NORTH NEW

Current Occupant: Recreation Reserve


Owners Name: KURINGAI COUNCIL

Address: Pacific Highway


Gordon Oct 1973

UBD MAP 29

Access

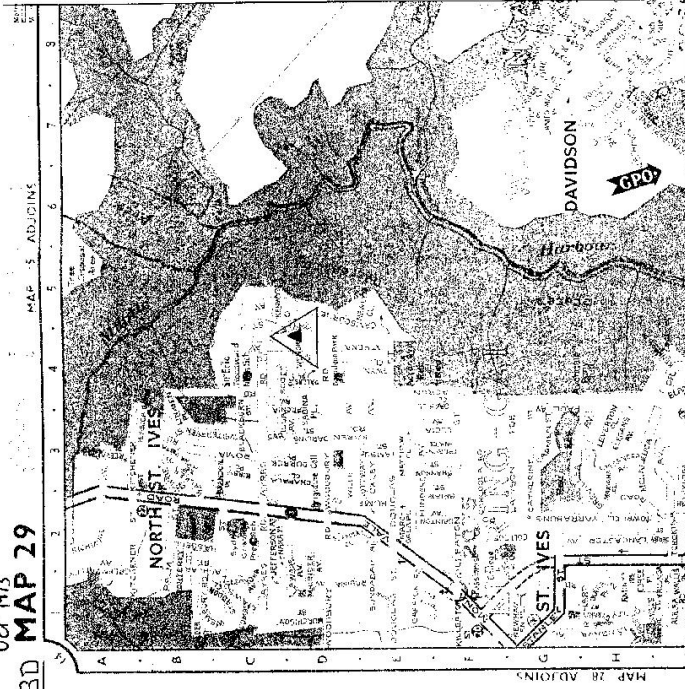

D. West, Government Printer, New South Wales - 1976

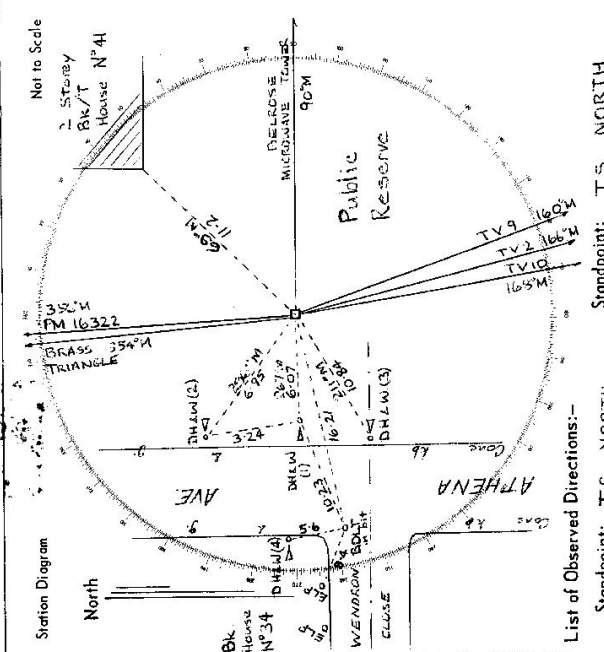

List of Observed Directions:-

Standpoint: TS NORTH		Standpoint: TS NORTH	
Station	Direction	Station	Direction
P.M. 16322	0 00 00	Brass Triangle	0 00 00
Ballex Microphone Tower	93 51 51	Bolt in bitumen	266 40 19
Channel 9 Tower	164 25 50	Drill Hole 4 Way (1)	274 55 41
" 2	170 20 12		
" 10	172 22 17		
Brass Triangle	357 00 46	Standpoint Bolt in bitumen	
		TS NORTH	0 00 00
		Drill Hole 4 Way (1)	355 06 21