

75-11


RECONNAISSANCE and MAINTENANCE REPORT

STATION TS 3564 NULLA NULLA

Co: HUME
 Ph: COROUJA

Map Sheet: LOWESDALE 1:50000 No: 8126 - S
 Inspected by: P.E. Stone Date: 17-5-78 &
 Authority LANDS DEPT. WAGGA Field Book: 506.

Beacon Diagram Not to Scale

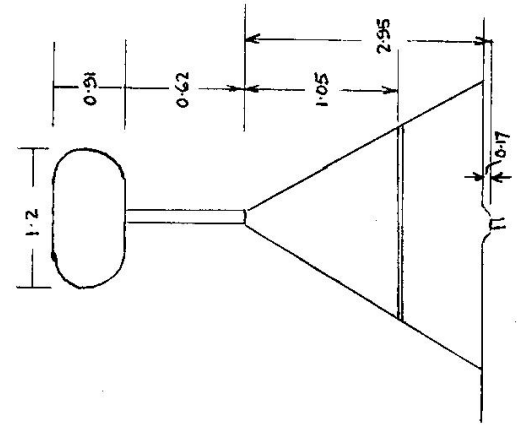

This Trig. Station has been:- Note: Cross out word or words which do not apply

1. Completely cleared to permit 360° vision to surrounding Trigs. ✓
2. Cleared by James-bearing _____ from Trig. Mast
3. Trig. Mast & Vanes have been painted white & black respectively. ✓
4. The Trig. was unpiled/~~not unpiled~~, dimensions now being: Mast vanes & rods placed by Victorian Lands Dept. Description of mark... Bronze Rod No. 300 should be explicit, e.g. Steel plug, Brass plug, Bolt, Concrete Pillar

Height of mark... _____ m ^{above} rock/concrete .0:17 m ^{above} below G.L.

Height of Top Vanes to Top Mark/~~Top pillar plate~~ ... 4.48 m Diameter of Vanes (vertical) .0:21 m.

Height of Cairn... _____ m. Diameter of Cairn... _____ m.

Length of Mast... 1.53 m. (approximate if not unpiled)

5. ~~AS 20138~~ set in conc/rock has been placed/d 8.181 m. bearing... 232 °M from Trig. Mast/~~pillar~~
6. ~~AS 20138~~ set in conc/soil has been placed/d 14.31-218 m. bearing... 283 °M from Trig. Mast/~~pillar~~
7. A... set in conc/soil has been placed/d _____ m. bearing... °M from Trig. Mast/~~pillar~~
8. A... set in conc/rock has been placed/d _____ m. bearing... °M from Trig. Mast/~~pillar~~
9. Connection ~~SSM 23138~~ to ~~Bronze rod~~ : 26:614 m. bearing... 117 °M
10. Connection ~~Bronze rod~~ to ~~Trig~~ : _____ m. bearing... °M
11. Connection... to... : _____ m. bearing... °M
12. Connection... to... : _____ m. bearing... °M
13. Diff. Ht. ~~Bronze rod~~ is 0:122 m. ^{above} Trig rod _{below}
14. Diff. Ht. ~~SSM 23138~~ is 0:762 m. ^{above} Trig rod _{below}
15. Diff. Ht. is _____ m. ^{above} below
16. Diff. Ht. is _____ m. ^{above} below

Date	Record of Station
11-5-73	G.N.B assigned name TS NULLA NULLA (no Hemo d)

Prepared by: R.A. WILLIAMS. Checked: AV 25-2-79.

STATION TS 3564



NULLA NULLA


Current Occupant.....

Address.....

Owners Name.....

Address.....


17-5-1978
Access 20-6-1979
See LOWESDALE 1:50000 map.

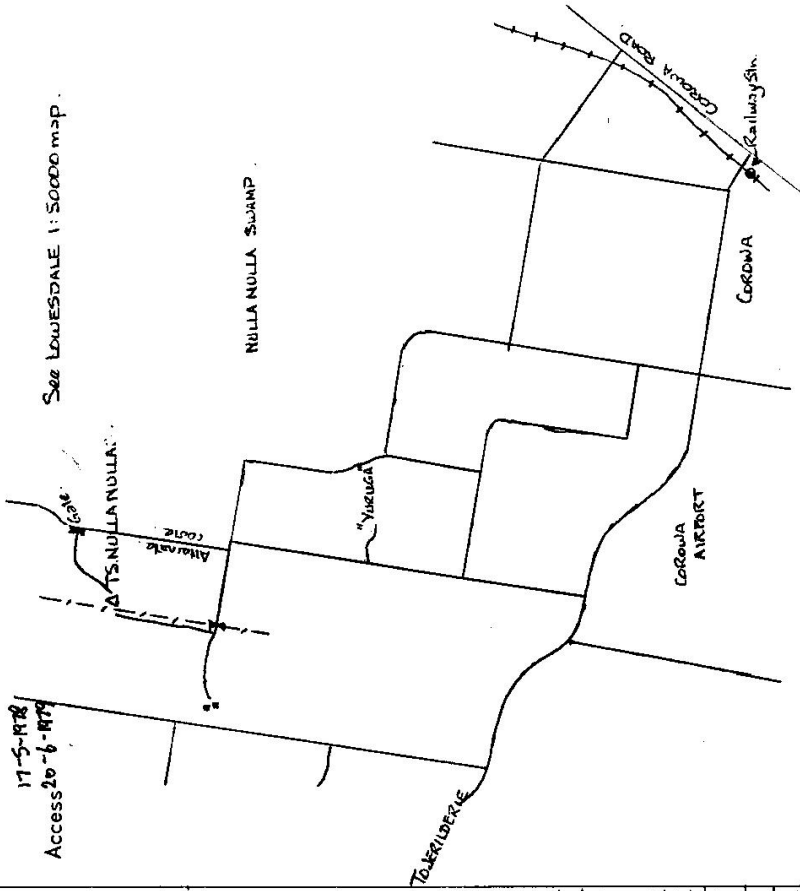

Not to Scale

Station Diagram

North

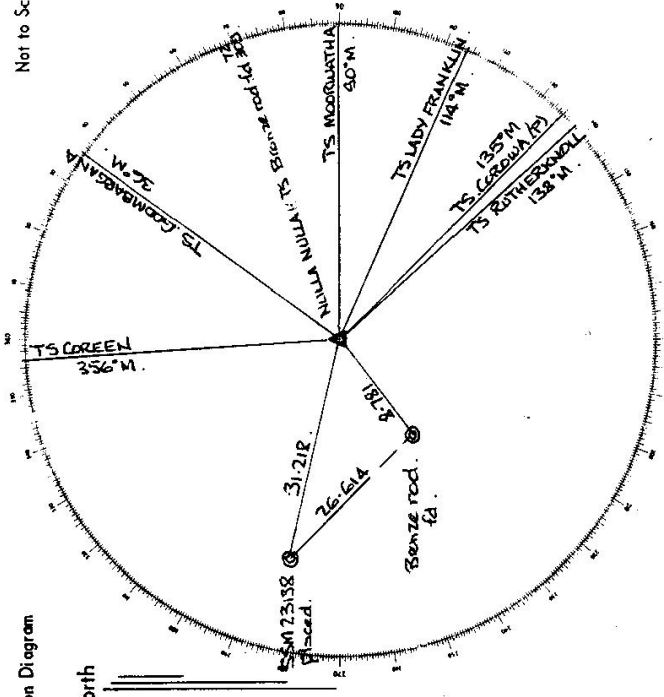

List of Observed Directions:-

Standpoint: Benzze road (T.S.) 345

Standpoint: SSM 23138

Station	Direction	Station	Direction
TS COROWA	0° 00' 00"	TS COROWA	0° 00' 00"
TS RUTHERHAM	140° 16' 33"	TS MOORWATHA	87° 38' 07"
Benzze road	236° 23' 11"	TS NULLA NULLA	107° 52' 41"
SSM 23138	287° 36' 10"	TS LADY FRANKLIN	105° 53' 39"
		Benzze road	122° 26' 54"
		TS COROWA (P)	134° 34' 19"
Station	Direction	Station	Direction

