



Land Information Centre.

GEODETIC SURVEY OF N.S.W.

GEODETIC STATION RECONNAISSANCE and MAINTENANCE REPORT

Description:

- Note: Cross out word or words which do not apply
- Cleared by lanes bearing  $325^{\circ}$   $320^{\circ}$  M. TELECOM MIREO WAVE TOWER APT. 000M 359' 1" M. ELR. 478 Mast & Vanes have been painted white & black respectively. ✓ NEW MAST & VANES PLACED 18.5.92.
  - The station/~~marker~~ was unpiled/~~AND REPAIRED~~ on 18.5.19.92, dimensions now being: ~~Copper Tube~~ should be explicit, e.g., S/Steel Pillar Plate, Steel plug, Brass plug, Bolt, G.I. Pipe
  - Description of mark: ~~Copper Tube~~ Level ~~mark~~ concrete; Mark is ~~AT~~ G.L. Height of Top Vanes to Top Mark/~~3.045~~ 3.045 m. Diameter of Vanes (vertical) 0.76 m. Height of Cairn 0.910 m. Diameter of Cairn 7.1 m. Name Plate ~~found~~/not ~~found~~/placed. Length of Mast 3.045 m. ~~(approximate if not specified)~~
  - A ~~Copper Tube~~ RM1 set in conc/~~mark~~ has been placed/found, bearing  $215^{\circ}$  M from ~~mark~~/Plug/~~marker~~
  - A ~~Copper Tube~~ RM2 set in conc/~~mark~~ has been placed/found, bearing  $37^{\circ}$  M from ~~mark~~/Plug/~~marker~~
  - A ~~mark~~ set in conc/rock has been placed/found, bearing  $^{\circ}$  M from Mast/Plug/Pillar
  - A ~~mark~~ set in conc/rock has been placed/found, bearing  $^{\circ}$  M from Mast/Plug/Pillar

8. Action required:


STANDPOINT: TRIG MARK.				STANDPOINT: COPPER TUBE RM12			
Mark	Direction	Horiz. Distance	Height Difference	Mark	Direction	Horiz. Distance	Height Difference
North Barrier (P)	0 00 00		above standpt.	North Barrier (P)	0 00 00		above standpt.
Copper Tube RM1	0 03 06	8.831	above standpt.	Copper Tube RM1	1 19 44	17.877	above standpt.
TOWER ON NUNDOOKA HILL LHS. 144 53 07			below standpt.	TRIG MARK	2 34 37	9.047	above standpt.
TOWER ON NUNDOOKA HILL RHS. 145 38 55			below standpt.	TOWER ON NUNDOOKA HILL LHS. 139 38 04			above standpt.
Copper Tube RM2	182 34 57	9.047	below standpt.	TOWER ON NUNDOOKA HILL RHS. 140 29 38			below standpt.
			above standpt.				above standpt.
			below standpt.				below standpt.

Prepared by: D. Kain.

Checked: *g f o r*

Noted on U.T.M. Card

SF 2733-1

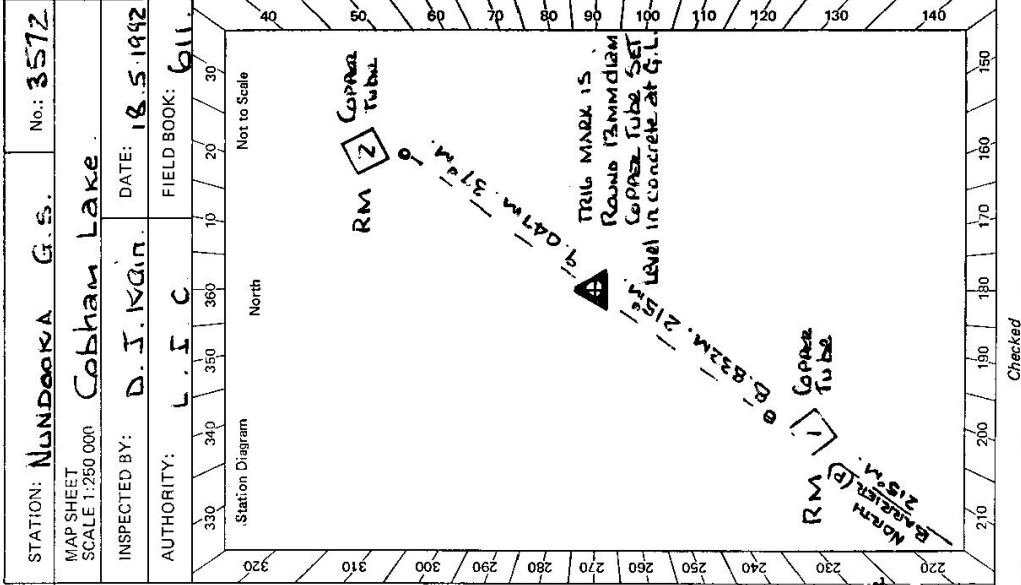

Checked


GEODETTIC STATION RECONNAISSANCE and MAINTENANCE REPORT

STATION: **NUNDOOKA G.S.** No.: **3512**

MAP SHEETS  
SCALE 1:250 000 **Cobham Lake BANCANNIA**

INSPECTED BY: **D.J. Kain** DATE: **18.5.92**

AUTHORITY: **L.I.C.** FIELD BOOK: **611.**

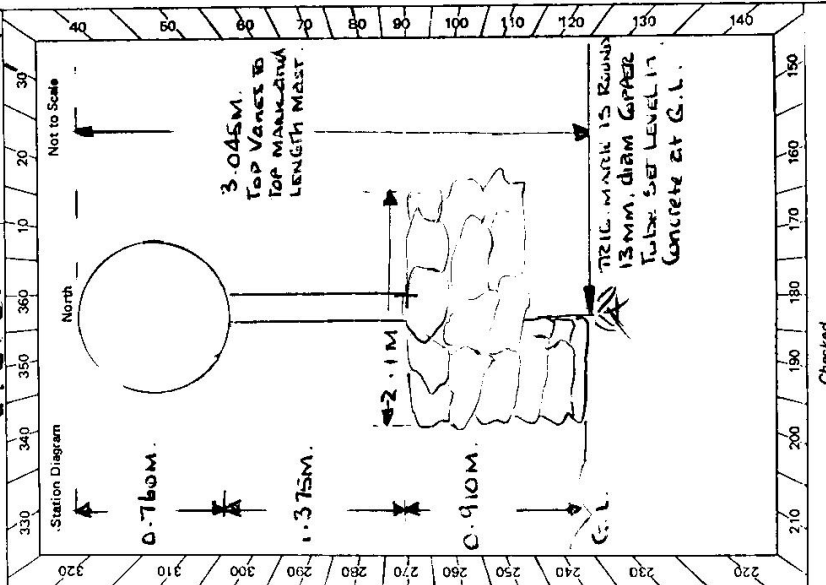

STANDPOINT: **COPPER TUBE RMI**

Mark	Direction	Horiz. Distance	Height Difference	Mark	Direction	Horiz. Distance	Height Difference
<b>NORTH BARRIER (P)</b>	<b>0 00 00</b>		above standpt.				above standpt.
<b>DOWNER ON NUNDOOKA HILLS</b>	<b>148 47 06</b>	<b>7</b>	below	<b>Calc. Centre of Gravity</b>			
<b>DOWNER ON NUNDOOKA HILLS</b>	<b>149 07 32</b>	<b>149</b>	below				
<b>TRIG. MARKS</b>	<b>180 03 08</b>	<b>8-832</b>	above standpt.				
<b>COPPER TUBE RMI</b>	<b>19 45 17</b>	<b>8790.064</b>	above standpt.				

STANDPOINT:

Mark	Direction	Horiz. Distance	Height Difference	Mark	Direction	Horiz. Distance	Height Difference
			above standpt.				above standpt.
			below				below
			above standpt.				above standpt.
			below				below
Prepared by: **D. Kain** Checked: **[Signature]** Noted on U.T.M. Card

