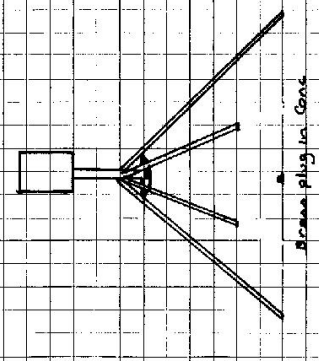
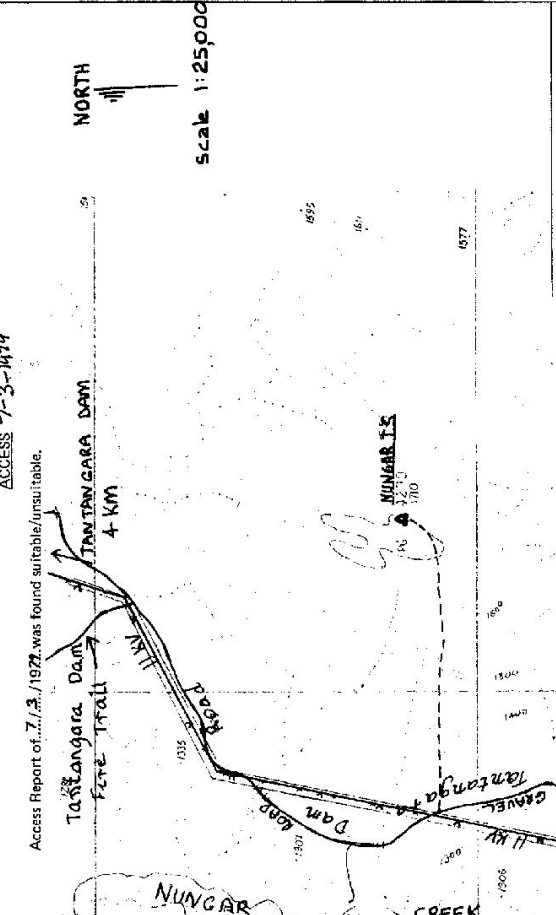


6:

SR 2733-2 D. West, Government Printer Beacon Diagram Not to Scale		STATION NUNGAR B.S. TS 3573
Owner's Name: Address: <i>Situated within the KESAWANAN NATIONAL PARK</i> Phone: Current Occupant: Address: Phone: ACCESS 7-3-1979		Access Report of 7.3.1979 was found suitable/unsuitable.
 <p><i>Beam plug in Conc</i></p> <p>STEEL GALVANISED PIPE GUARDED WITH BLACK SQUARE CONICAL VANES</p>		 <p>NUNGAR IS</p> <p>TANGGARA DAM</p> <p>NUNGAR CREEK</p> <p>Scale 1:25000</p>
This section to be completed by officer constructing pillar. Original station mark found/not found. Description of mark: Original beacon found/not found. Description of beacon: Height Top of Vanes to Top Markm. Height of markm. above G.L. below Diameter of Vanesm. Height of Cairnm. Original Beacon has/has not been destroyed by me.		Date 7.3.79 Record of Station <i>Reexamined on 7.3.79 during field completion of Tanggara Dam. Access taken off the Tanggara 1:25,000 (original).</i>