


CENTRAL MAPPING AUTHORITY GEODETIC SURVEY OF N.S.W.

GEODETIC STATION RECONNAISSANCE and MAINTENANCE REPORT

STATION: *Kunvery G.S.* No.: *3575*
 MAP SHEET SCALE 1:250 000
 INSPECTED BY: *ML Morrison* DATE: *20/11/78*
 AUTHORITY: *CMA* FIELD BOOK: *1711*

- Description: *Note: Cross out word or words which do not apply*
1. Cleared by lanes bearing..... from Trig. Mast
 2. Mast & Vanes have been painted white & black respectively.
 3. The station/pillar was unpiled/not unpiled/constructed on..... dimensions now being:
 Description of mark..... should be explicit; e.g., S/Steel Pillar Plate, Steel plug, Brass plug, Bolt, G.I. Pipe
 Height of mark.....m. ^{above} rock/concrete; Mark is.....m. ^{above} G.L.
 Height of Top Vanes to Top Mark/Pillar plate.....m. Diameter of Vanes (vertical).....m. *0.92*
 Height of Cairn.....m. *0.90* Diameter of Cairn.....m. *1.50* Name Plate found/not found/placed.
 Length of Mast.....m. (approximate if not unpiled) *3.95*
 4. A..... set in conc./rock ~~has been placed~~/found, bearing.....° M from Mast/Plug/Pillar
 5. A..... set in conc./rock has been placed/round, bearing.....° M from Mast/Plug/Pillar
 6. A..... set in conc./rock has been placed/round, bearing.....° M from Mast/Plug/Pillar
 7. A..... set in conc./rock has been placed/round, bearing.....° M from Mast/Plug/Pillar
 8. Action required:.....

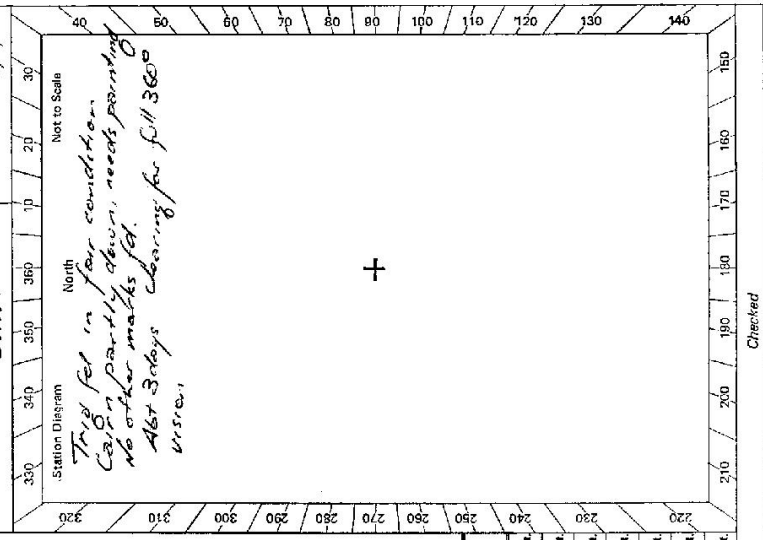


STANDPOINT:

Mark	Direction	Horiz. Distance	Height Difference	Mark	Direction	Horiz. Distance	Height Difference
			above standpt.				above standpt.
			below standpt.				below standpt.
			above standpt.				above standpt.
			below standpt.				below standpt.
Prepared by: *[Signature]* Checked: *[Signature]*
 Date: *27/11/78* Station: *Kunvery G.S.*
 Notes on U.T.M. Card

St 2739 - 2 D. West, Government Printer

Beacon Diagram

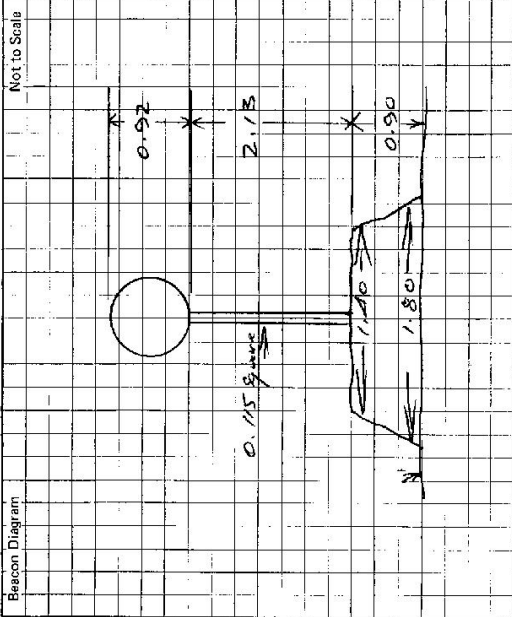

This section to be completed by officer constructing pillar.

Original station mark found/not found.

Description of mark:

Original beacon found/not found.

Description of beacon:

Height Top of Vanes to Top Mark.....m.

Height of mark.....m. above rock/conc.....m. below G.L.

Diameter of Vanes.....m. Height of Cairn.....m.

Original Beacon has/has not been destroyed by me.

STATION *NUNNERY TS 3575*

Owner's Name:

Address:

Phone:

Current Occupant:

Address:

Phone:

ACCESS

Access Report of *20/11/18* was found suitable/unsuitable.

Direction

0.00 TARALGO RD. HEAD SOUTH TO WEST GULLBURN

0.10 TURN LEFT FOLLOW ROAD TO BANNAHASYKE

5.20 PASS ABOVE LEFT TO 'EMARU'

7.05 TURN LEFT THROUGH IRON GATE

7.85, 9.55 GATES

10.55 PASS SHED ON RIGHT FOLLOW RIDGE

10.85 PARK TRUCK AT END OF CLEARING. WALK ALONG

ROCKY SPUR TO TRIG ABT 10 MINS EASY WALK.

Date

Record of Station