

74098

Department of Lands
 Trigonometrical Survey of N.S.W.
RECONNAISSANCE and MAINTENANCE REPORT

This Trig. Station has been:-

Note: Cross out word or words which do not apply

1. Completely cleared to permit 360° vision to surrounding Trigs. ✓
2. Cleared by lanes bearing. ✓
3. Trig. Mast & Vanes have been painted white & black respectively. ✓
4. The Trig. was unpainted/~~not repainted~~, dimensions now being: Original Station Mark found: ~~rock~~
 Description of mark: St. Steel Trig. pin ✓ should be explicit, e.g. Steel plug, Brass plug, Bolt, G.I. Pipe
 Height of mark: 0.032 m ^{above} ~~below~~ rock/concrete 1.1 m ~~above~~ ^{below} G.L.
 Height of Top Vanes to Top Mark: 2.808 m. Diameter of Vanes (vertical) 1.010 m.
 Height of Cairn: 0.900 m. Diameter of Cairn: 1.400 m.
 Length of Mast: 2.840 m. (~~approximate if not printed~~)

5. A. ~~set in conc/rock has been placed~~ m. bearing °M from Trig. Mast
6. A. ~~set in conc/soil has been placed~~ m. bearing °M from Trig. Mast
7. A. ~~set in conc/soil has been placed~~ m. bearing °M from Trig. Mast
8. A. ~~set in conc/rock has been placed~~ m. bearing 1.1 °M from Trig. Mast
Mast of Vanes were found
1.1m above the ground.
Station was repaired.
9. Connection..... to m. bearing °M
10. Connection..... to m. bearing °M
11. Connection..... to m. bearing °M
12. Connection..... to m. bearing °M
13. Diff. Ht. is m. ^{above} ~~below~~
14. Diff. Ht. is m. ^{above} ~~below~~
15. Diff. Ht. is m. ^{above} ~~below~~
16. Diff. Ht. is m. ^{above} ~~below~~


Prepared by: DK

Checked: AK

Noted on U.T.M. Card

STATION Oakfields G.S. TS 3587
 Co: DURHAM Ph: ROACHBL
 Map Sheet: SINGLEDEN No: 1:250,000
 Inspected by: DAVID J KAM Date: 2 up 1 down 14/11
 Authority: _____ Field Book: _____

Beacon Diagram Not to Scale

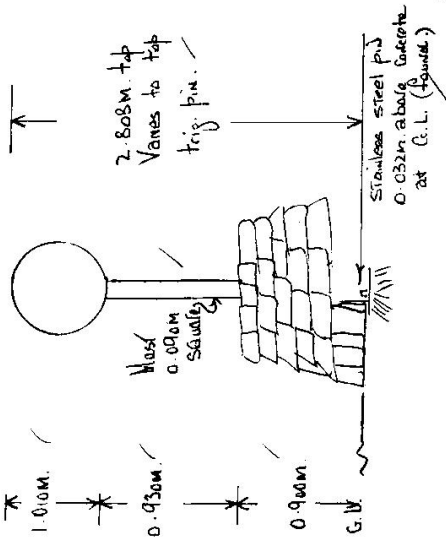

Date	Record of Station

Checked

7-5 103

Department of Lands

Integrating survey of N.S.W

RECONNAISSANCE and MAINTENANCE REPORT

STATION TS OAKFIELDS (3587)

This Trig. Station has been:-

Note: Cross out word or words which do not apply

1. Completely cleared to permit 360° vision to surrounding Trigs. ✓
2. Cleared by ~~lines bearing~~ from Trig. Mast ✓
3. Trig. Mast & Vanes have been painted white & black respectively. ✓
4. The Trig. was unpiled/~~not unpiled~~, dimensions now being:

Description of mark ~~3. S. P.V.~~ should be explicit, e.g. Steel plug, Brass plug, Bolt, Concrete Pillar
 Height of mark ~~0.05~~ ^{above} ~~rock~~ ^{concrete} ~~0.05~~ m above ^{junction} ~~G.L.~~
 Height of Top Vanes to Top Mark/~~Top pillar plate~~ 2.91 m Diameter of Vanes (vertical) 1.01 m.
 Height of Cairn 1.0 m. Diameter of Cairn 1.2 m.

5. A ~~Copper Spike~~ set in conc/~~rock~~ has been placed/d 3.25 m. bearing 159 °M from Trig. ~~Mast~~/pillar
6. A G.I.P. set in conc/~~soil~~ has been placed/d 3.539 m. bearing 193 °M from Trig. ~~Mast~~/pillar
7. A set in conc./soil has been placed/d m. bearing °M from Trig. Mast/pillar
8. A set in conc./rock has been placed/d m. bearing °M from Trig. Mast/pillar

9. Connection G.I.P. to C.S. : 2.021 m. bearing 79 °M
10. Connection to : m. bearing °M
11. Connection to : m. bearing °M
12. Connection to : m. bearing °M

13. Diff. Ht. Trig Plug is 0.101 m. ^{above} C.S.
14. Diff. Ht. Trig Plug is 0.122 m. ^{above} G.I.P.
15. Diff. Ht. G.I.P. is 0.022 m. ^{above} C.S.
16. Diff. Ht. is m. ^{above} below junction

Prepared by: edg Checked: _____

Co: Durham

Map Sheet: Cambwell N

Inspected by: P. McBeath

Autority: ISD NOLA

Ph: Rouche


Nb: 9133

Date: 29.11.77

Field Book: PP 559

Beacon Diagram

Not to Scale

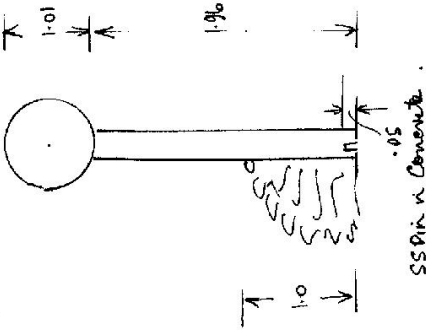

Date	Record of Station
29/11/77	Unpiled & repaired - Marks fd.

STATION TS OAKFIELDS TS 3587

Current Occupant.....

Owners Name: K. Kelleher

Address.....

New England Highway
Merriden

29.11.1977

Leisure

0-0 Searcher Inn at Aberdeen - take Roushel Road.

0-15 Cross railway, turn off - straight ahead.

8-25 "Lake Glenburn" then - straight ahead.

22-05 "St Albans + Swaleton" then - straight ahead.

22-80 Old Church on LHS.

23-85 Cross Cameron Bridge

Turn left through wooden gate - fence at top of hill.

24-35 Turn left towards cutting - just before grid

24-6 Leave fence line - head south down ridge

24-85 Creek crossing - head towards stockyards

25-45 Through Iron Gate - stockyards on left, follow track

25-6 up cutting

25-95 Cross gully.

26-15 Left at top of cutting along ridge

26-25 Pass through old fence near iron banks.


27-25 End of track - leave vehicle - walk south along fence line up slope to trig.

(About 15 min walk with load.)

Not to Scale

Station Diagram

North

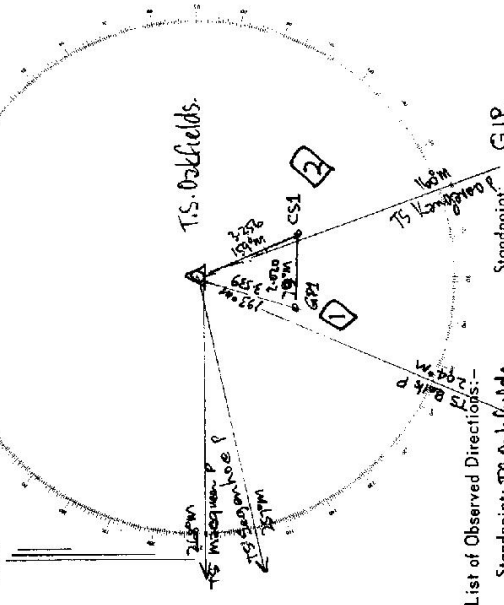

List of Observed Directions:-

Station	Direction	Station	Direction
TS Kangaroo P	0° 0' 0"	TS Kangaroo P	0° 0' 0"
GIP	33° 51' 24.5"	TS Oakfields	93° 54' 04.5"
TS Bulk Min P	44° 03' 42.14"	CS1	291° 05' 22.5"
TS Sargahoe P	97° 48' 40.17"		
TS MacQueen P	108° 17' 11.58"		
CS1	289° 33' 51"		

GEODETTIC SURVEY OF N.S.W.

CENTRAL MAPPING AUTHORITY

GEODETTIC STATION RECONNAISSANCE and MAINTENANCE REPORT

Description:

Note: Cross out word or words which do not apply

1. Cleared by lances bearing..... from Trig, Mast
2. Mast & Vanes have been painted white & black respectively.
3. The station/pillar was unpiled/not unpiled/constructed on..... 19....., dimensions now being:
Description of mark.....should be explicit, e.g., S/Steel Pillar/Plate, Steel plug, Brass plug, Bolt, G.I. Pipe
Height of mark.....m. above rock/concrete; Mark is ^{above} ~~below~~ G.L.
- Height of Top Vanes to Top Mark/Pillar platem. ~~only~~ Diameter of Vanes (vertical).....m.
- Height of Cairn.....m. Diameter of Cairn.....m. Name Plate found/not found/placed.
- Length of Mast.....m. (approximate if not applied)
4. A.....set in conc/rock has been placed/found, bearing.....° M from Mast/Plug/Pillar
5. A.....set in conc/rock has been placed/found, bearing.....° M from Mast/Plug/Pillar
6. A.....set in conc/rock has been placed/found, bearing.....° M from Mast/Plug/Pillar
7. A.....set in conc/rock has been placed/found, bearing.....° M from Mast/Plug/Pillar
8. Action required:.....

STANDPOINT:

Mark	Direction	Horiz. Distance	Height Difference	Mark	Direction	Horiz. Distance	Height Difference
			above standpt.				above standpt.
			below				below
			above standpt.				above standpt.
			below				below
Prepared by: AS

Checked: AS

Noted on U.T.M. Card

51 2733-1

STATION: **DAK FIELDS GS.** TS No.: **3587**

MAP SHEET SCALE 1:280 000 *Muswellbrook*

INSPECTED BY: **G JONES** DATE: **6-9-79**

AUTHORITY: **CMA** FIELD BOOK: **1776**

Station Diagram

North

+
Not to Scale

St 2728-2 D. West, Government Printer

Beacon Diagram Not to Scale	<p style="text-align: right;">STATION <u>OAKFIELDS GS TS 3587</u></p> <p>Owner's Name: Address: Phone:</p> <p>Current Occupant: Address: Phone:</p> <p>Phone: <u>6-9-1979</u></p> <p>ACCESS <u>6-9-1979</u></p> <p>Access Report of <u>27/11/1977</u> was found <u>suitable/unsuitable</u>.</p> <p>0-0 <u>Legenhe Im at ABERDEEN. - take the Rouchel Road.</u> 0-15 <u>Cross railway.</u> 8-25 <u>'Lake Glenbawn' turnoff on left - straight ahead.</u> 16-7 <u>'St Johns' church on right.</u> 17-3 <u>Small causeway.</u> 19-9 <u>House and ponds on left. (Owner's house)</u> 20-1 <u>Turn left onto dirt track, 50m before grid. Follow the</u> <u>travelling stock route down across causeway.</u> 20-4 <u>Through iron gate on right, follow fence on left in a</u> <u>narrower direction.</u> 20-6 <u>Under power lines.</u> 20-8 <u>At corner of fence, follow faint track in a NW direction,</u> <u>across paddock, through trees, then up spur</u> <u>to fence.</u> 21-4 <u>At fence, to NW track to the right, with fence on left.</u> 21-7 <u>Through iron gate.</u> 21-8 <u>Drive across dam wall. (dam on left).</u> 22-4 <u>Dam on right.</u> 23-2 <u>Straight ahead. Other track goes back to the right</u> 23-5 <u>fence turn up to the right and follow fence to try</u> <u>steep sidelaps, not to be attempted in wet weather.</u></p> <p>Date: <u>23-8</u> <u>Stop truck</u> <u>20 metre walk to try.</u></p> <p>(<u>NB! In dry weather there is enough room to turn</u> <u>vehicle and trailer around 100m before try.</u>)</p>
Beacon Diagram Not to Scale	<p>This section to be completed by officer constructing pillar.</p> <p>Original station mark found/not found.</p> <p>Description of mark:</p> <p>Original beacon found/not found.</p> <p>Description of beacon:</p> <p>Height Top of Vanes to Top Mark m.</p> <p>Height of mark m. above rock/conc. m. below G.L.</p> <p>Diameter of Vanes m. Height of Cairn m.</p> <p>Original Beacon has/has not been destroyed by me.</p>