

76 (m)

Department of Lands  
 STATION T5 OAKLANDS 3589  
 Co: URANA Ph: CLEAR HILL  
 Map Sheet: OAKLANDS No: 8126-N  
 Inspected by: H.G. HELSHEIM Date: 15-07-76  
 Authority: DEPT OF LANDS Field Book: P25671


Note: Cross out word or words which do not apply

1. Completely cleared to permit 360° vision to surrounding Trig.
2. Cleared by lanes bearing 115°M. through to 5°M. from Trig. Mast
3. Trig. Mast & Vanes have been painted white & black respectively. ✓
4. The Trig. was unspiled / not unspiled, dimensions now being:
  - Description of mark: R. Mast. Survey Corps Plug, Brass plug, Bolt, Concrete Pillar
  - Height of mark: 1.15 m above rock/concrete
  - Height of Top Vanes to Top Mark/Top-pillar-plate: 4.41 m Diameter of Vanes (vertical): 0.915 m.
  - Height of Conn: Diameter of Conn: m.

5. A. ~~set in conc/rock has been placed/fd~~ m. bearing
6. A. ~~set in conc/soil has been placed/fd~~ m. bearing
7. A. ~~set in conc/soil has been placed/fd~~ m. bearing
8. A. ~~set in conc/rock has been placed/fd~~ m. bearing

9. Connection: to m. bearing
10. Connection: to m. bearing
11. Connection: to m. bearing
12. Connection: to m. bearing
13. Diff. Ht. is m. above/below
14. Diff. Ht. is m. above/below
15. Diff. Ht. is m. above/below
16. Diff. Ht. is m. above/below

Prepared by: W. D. D. Checked: W. D. D.

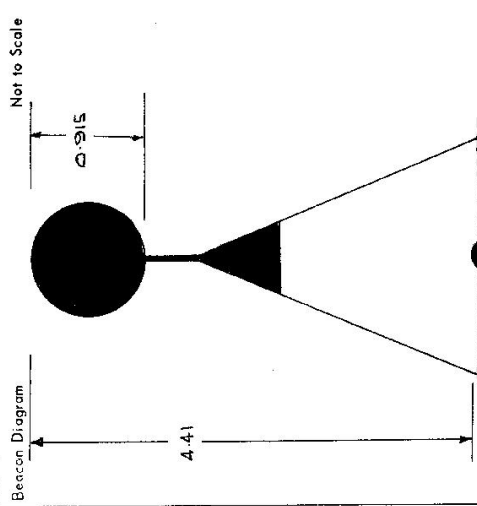

Date

Record of Station


STATION TS OAKLANDS 3589

Owners Name..... Current Occupant.....

Address..... Address.....


Station Diagram

North

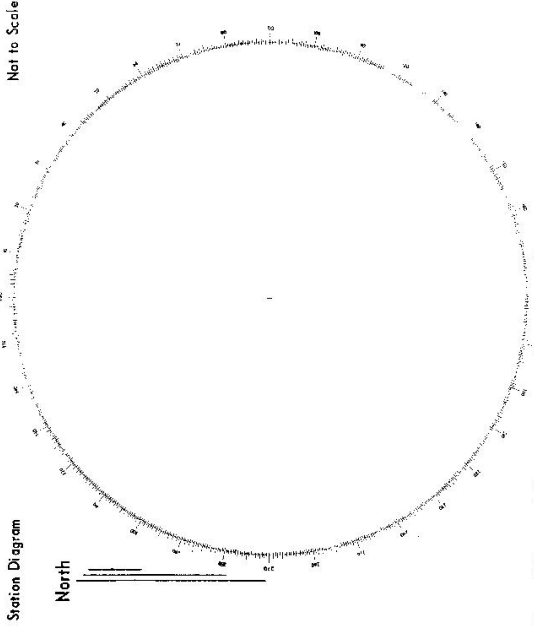

Access 15-07-1976  
To Berrigan

SCALE 1:50000

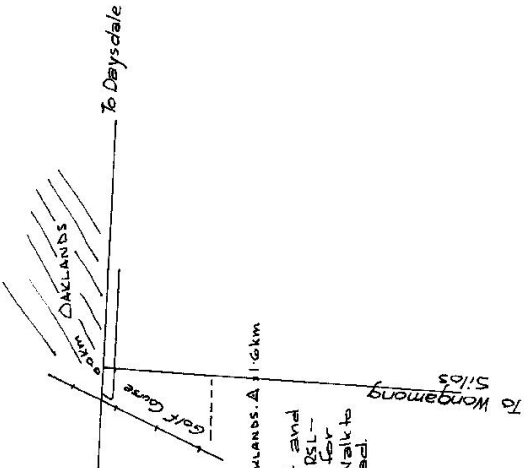

TS OAKLANDS A 1.6km  
0.0 km Oaklands Main Street and road south to Wongamong (DSL - Club on corner) Travel south for 1.6kms. Leave vehicle here. Walk to TS 150m. TS Visible from Road.

List of Observed Directions:-

Standpoint:		Standpoint:	
Station	Direction	Station	Direction
Station	Direction	Station	Direction