

GEODETTIC SURVEY OF M.S.W.

CENTRAL MAPPING AUTHORITY

GEODETTIC STATION RECONNAISSANCE and MAINTENANCE REPORT

- Description:
1. Cleared by James bearing *All around* Note: Cross out word or words which do not apply from Trig. Mast
2. Mast & Vanes have been painted white & black respectively. in cairn of rocks found
3. The station/pillar was unpiled/hot unpiled/constructed on 19....., dimensions now being:
- Description of mark.....should be explicit, e.g, S/Steel Pillar Plate, Steel plug, Brass plug, Bolt, G.I. Pipe
- Height of mark.....m. ^{above} _{below} rock/concrete; Mark is.....m. ^{above} _{below} G.L.
- Height of Top Vanes to Top Mark/Pillar platem. Diameter of Vanes (vertical).....m.
- Height of Cairn.....m. Diameter of Cairn.....m. Name Plate found/not found/placed.
- Length of Mast.....m. (approximate if not unpiled)
4. A.....set in conc/rock has been placed/found, bearing.....°M from Mast/Plug/Pillar
5. A.....set in conc/rock has been placed/found, bearing.....°M from Mast/Plug/Pillar
6. A.....set in conc/rock has been placed/found, bearing.....°M from Mast/Plug/Pillar
7. A.....set in conc/rock has been placed/found, bearing.....°M from Mast/Plug/Pillar
8. Action required: *Station needs to be replaced*

STANDPOINT:

Mark	Direction	Horiz. Distance	Height Difference	Mark	Direction	Horiz. Distance	Height Difference
			above standpt				above standpt
			below standpt				below standpt
			above standpt				above standpt
			below standpt				below standpt
Prepared by: *P.K. Bamola* 27/6/22 Checked: *Checked* Noted on U.T.M. Card

STATION: *CALLEN* No.: *2594*

MAP SHEET SCALE 1:250 000 *CANBEER*


INSPECTED BY: *P.K. BAMOLA* DATE: *MAY 79*

AUTHORITY: *CMA* FIELD BOOK:

Station Diagram

North

Not to Scale

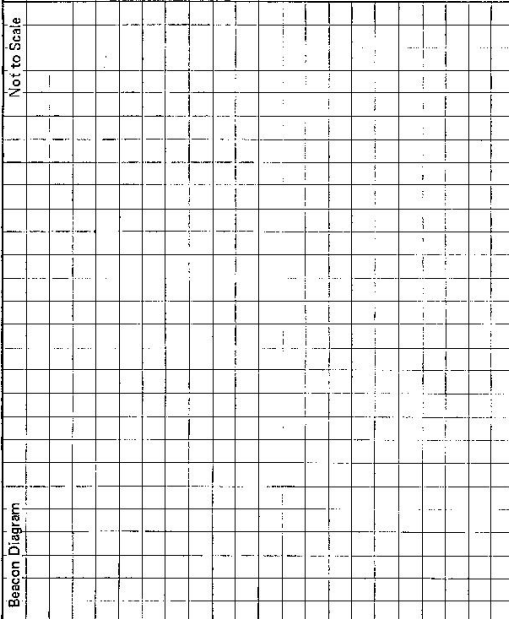STATION DALLEN TS 3594	<p> Owner's Name: Address: Phone: Current Occupant: Address: Phone: ACCESS Access Report of/19..... was found suitable/unsuitable. <i>Refer. Dallen 1:25000 Sheet</i> </p>
Beacon Diagram 	<p> This section to be completed by officer constructing pillar. Original station mark found/not found. Description of mark: Original beacon found/not found. Description of beacon: Height Top of Vanes to Top Markm. Height of markm. above G.L. Below rock/concm. below Diameter of Vanesm. Height of Cairnm. Original Beacon has/has not been destroyed by me. </p>
Date	Record of Station

CENTRAL MAPPING AUTHORITY

GEODETIC SURVEY OF N.S.W.

GEODETIC STATION RECONNAISSANCE and MAINTENANCE REPORT

STATION: **CALLAN** No.: **3594**

MAP SHEET **CAMBERRA**
SCALE 1:250 000

INSPECTED BY: **R. ELLS** DATE: **17/9/81**

AUTHORITY: **C. M. A.** FIELD BOOK: **20736**

Description: **Cleared by lanes bearing 194°M ~ 182°M** *Note: Cross out word or words which do not apply*

1. Cleared by lanes bearing **194°M ~ 182°M** from Trig. Mast
 2. ~~Mast & Vane~~ have been painted ~~white & black~~ respectively.

3. The station/pillar was ~~unpiled~~/not unpiled/~~repositioned~~ on **17/02/1981**, dimensions now being:

Description of mark..... should be explicit, e.g., S/Steel Pillar Plate, Steel plug, Brass plug, Bolt, G.I. Pipe

Height of mark.....m, above/below rock/concrete; Mark is.....m, above/below G.L.

Height of Top Vanes to Top Mark/Pillar plate.....m. Diameter of Vanes (vertical).....m.

Height of Cairn.....m. Diameter of Cairn.....m. Name Plate found/not found/placed.

Length of Mast.....m. (approximate if not unpiled)

4. A.....set in conc/rock has been placed/found, bearing.....°M from Mast/Plug/Pillar

5. A.....set in conc/rock has been placed/found, bearing.....°M from Mast/Plug/Pillar

6. A.....set in conc/rock has been placed/found, bearing.....°M from Mast/Plug/Pillar

7. A.....set in conc/rock has been placed/found, bearing.....°M from Mast/Plug/Pillar

8. Action required: **GOOD S.W.C. CLEARING SITE - NO CLEARINGS ON HILLS**

STANDPOINT:

STANDPOINT:


Mark	Direction	Horiz. Distance	Height Difference	Mark	Direction	Horiz. Distance	Height Difference
			above standpt				above standpt
			below standpt				below standpt
			above standpt				above standpt
			below standpt				below standpt
Prepared by: *Ells* 4/1/81

Checked:

Noted on U.T.M. Card

Checked

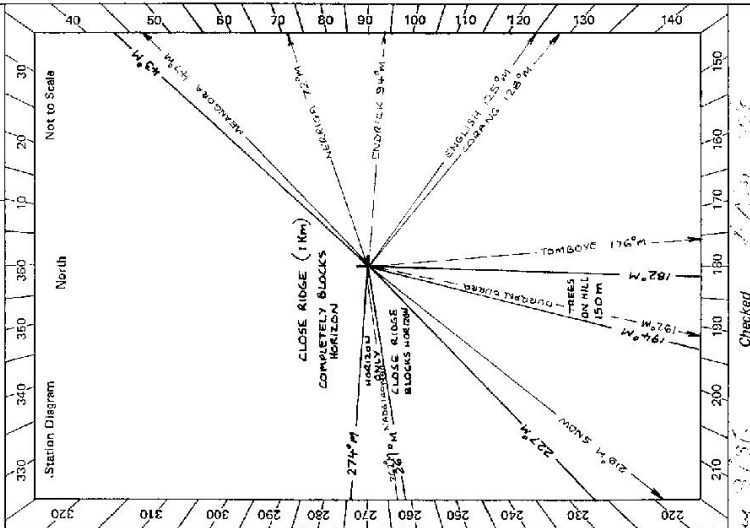

GS 24

STATION	DALLEN TS 3594																							
<p>Owner's Name: MR K. L. KNIGHTS Address: 53A NORTHCOOTE RD CHULLORA NSW Phone: (02) 642-5648</p> <p>Manager: Contact/Occupant: MR GOOTH Address: CALLEN FORD Address: CALLEN VIA GOULBURN Phone: (248) 48-5157</p> <p>ACCESS 17-9-1981</p> <p>Access Report of/19..... was found suitable unsuitable</p> <table border="1" style="width:100%; border-collapse: collapse;"> <thead> <tr> <th style="width: 10%;">KM</th> <th style="width: 90%;">FEATURE</th> </tr> </thead> <tbody> <tr> <td>0.0</td> <td>NERRIGA HOTEL - HEAD SOUTH TOWARDS BRADWOOD</td> </tr> <tr> <td>0.53</td> <td>TURN RIGHT ~ SIGN " CALLEN IS GOULBURN 75 "</td> </tr> <tr> <td>7.33</td> <td>CORANG RIVER BRIDGE</td> </tr> <tr> <td>12.02</td> <td>CONCRETE CAUSEWAY</td> </tr> <tr> <td>17.55</td> <td>SHALHUVEN RIVER BRIDGE</td> </tr> <tr> <td>19.64</td> <td>TURN LEFT THROUGH GATE ~ SIGN " CALLEN FORD "</td> </tr> <tr> <td>19.79</td> <td>PASS THROUGH IRON GATE TO LEFT OF HOUSE - FOLLOW FAINI TRACK AROUND WESTERN SIDE OF HILL</td> </tr> <tr> <td>20.05</td> <td>PASS OLD CARS ON LEFT</td> </tr> <tr> <td>20.17</td> <td>TURN LEFT UP SPUR TO TRIG</td> </tr> <tr> <td>20.3</td> <td>" CALLEN " TRIG</td> </tr> </tbody> </table>	KM	FEATURE	0.0	NERRIGA HOTEL - HEAD SOUTH TOWARDS BRADWOOD	0.53	TURN RIGHT ~ SIGN " CALLEN IS GOULBURN 75 "	7.33	CORANG RIVER BRIDGE	12.02	CONCRETE CAUSEWAY	17.55	SHALHUVEN RIVER BRIDGE	19.64	TURN LEFT THROUGH GATE ~ SIGN " CALLEN FORD "	19.79	PASS THROUGH IRON GATE TO LEFT OF HOUSE - FOLLOW FAINI TRACK AROUND WESTERN SIDE OF HILL	20.05	PASS OLD CARS ON LEFT	20.17	TURN LEFT UP SPUR TO TRIG	20.3	" CALLEN " TRIG	<p>Beacon Diagram</p> <p style="text-align: right;">Not to Scale</p> <table border="1" style="width:100%; border-collapse: collapse;"> <tr> <td style="width: 100px; height: 100px; vertical-align: top;"> <p>CHAIR AND POLE IN POOR CONDITION DISCS ARE NON EXISTENT</p> <p>GOOD PILLAR SITE NO CLEARING REQUIRED</p> <p>MR KNIGHTS HAS GIVEN A VERBAL OK TO PILLAR CONSTRUCTION SEE REPORT</p> </td> </tr> </table> <p>This section to be completed by officer constructing pillar.</p> <p>Original station mark found/not found.</p> <p>Description of mark:</p> <p>Original beacon found/not found.</p> <p>Description of beacon:</p> <p>Height Top of Vane to Top Markm.</p> <p>Height of markm. above G.L. below</p> <p>Diameter of Vanem. Height of Cairnm.</p> <p>Original Beacon has/has not been destroyed by me.</p>	<p>CHAIR AND POLE IN POOR CONDITION DISCS ARE NON EXISTENT</p> <p>GOOD PILLAR SITE NO CLEARING REQUIRED</p> <p>MR KNIGHTS HAS GIVEN A VERBAL OK TO PILLAR CONSTRUCTION SEE REPORT</p>
KM	FEATURE																							
0.0	NERRIGA HOTEL - HEAD SOUTH TOWARDS BRADWOOD																							
0.53	TURN RIGHT ~ SIGN " CALLEN IS GOULBURN 75 "																							
7.33	CORANG RIVER BRIDGE																							
12.02	CONCRETE CAUSEWAY																							
17.55	SHALHUVEN RIVER BRIDGE																							
19.64	TURN LEFT THROUGH GATE ~ SIGN " CALLEN FORD "																							
19.79	PASS THROUGH IRON GATE TO LEFT OF HOUSE - FOLLOW FAINI TRACK AROUND WESTERN SIDE OF HILL																							
20.05	PASS OLD CARS ON LEFT																							
20.17	TURN LEFT UP SPUR TO TRIG																							
20.3	" CALLEN " TRIG																							
<p>CHAIR AND POLE IN POOR CONDITION DISCS ARE NON EXISTENT</p> <p>GOOD PILLAR SITE NO CLEARING REQUIRED</p> <p>MR KNIGHTS HAS GIVEN A VERBAL OK TO PILLAR CONSTRUCTION SEE REPORT</p>																								
Date	Record of Station																							