

GEODETIC SURVEY OF M.S.W.

CENTRAL MAPPING AUTHORITY


GEODETIC STATION RECONNAISSANCE and MAINTENANCE REPORT

STATION: **S.M.A. 1154** No.: **36**

MAP SHEET SCALE 1:250 000 **TANTANGARA 1:100,000**

INSPECTED BY: **R. COOK** DATE: **7-3-79**

AUTHORITY: **C.M.A.** FIELD BOOK:

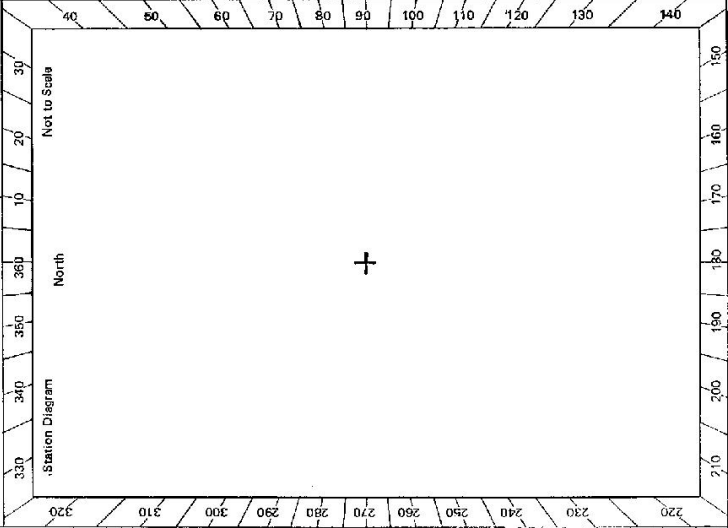

Description:

1. Cleared by lanes bearing. *Note: Cross out word or words which do not apply*

2. Mast & Vanes have been painted white & black respectively.

3. The station/pillar was unpiled/not unpiled/constructed on.....19....., dimensions now being:

Description of mark: **Steel Plug** should be explicit, e.g., S/Steel Pillar Plate, Steel plug, Brass plug, Bolt, G.I. Pipe

Height of mark.....m. ^{above} rock/concrete; Mark is.....m. ^{above} _{below} G.L.

Height of Top Vanes to Top Mark/Pillar plate.....m. Diameter of Vanes (vertical).....m.

Height of Cairn.....m. Diameter of Cairn.....m. Name Plate found/not found/placed.

Length of Mast.....m. (approximate if not unpiled)

4. A.....set in conc/rock has been placed/found, bearing.....° M from Mast/Plug/Pillar

5. A.....set in conc/rock has been placed/found, bearing.....° M from Mast/Plug/Pillar

6. A.....set in conc/rock has been placed/found, bearing.....° M from Mast/Plug/Pillar

7. A.....set in conc/rock has been placed/found, bearing.....° M from Mast/Plug/Pillar

8. Action required: **AVERAGE**.....**CONSTRUCTION**.....**supported by light timber**.....**10 minutes**.....**swab**.....

STANDPOINT:


Mark	Direction	Horiz. Distance	Height Difference	Mark	Direction	Horiz. Distance	Height Difference
			above standpt.				above standpt.
			below standpt.				below standpt.
			above standpt.				above standpt.
			below standpt.				below standpt.
Prepared by: **Rodney Cook** Checked:

Noted on U.T.M. Card

SI 2753-1

S1: 2733-2 D. West, Government Printer Beacon Diagram Not to Scale	Owner's Name: Address: <i>S. situated within the</i> <i>KORSELUKOR NATIONAL PARK</i> Phone: Current Occupant: Address: Phone: ACCESS Access Report of Z.Z./1972 was found suitable/unsuitable.	STATION S.M.A. 1154 IS 36 Scale 1:25,000 NORTH
This section to be completed by officer constructing pillar. Original station mark found/not found. Description of mark: Original beacon found/not found. Description of beacon: Height Top of Vanes to Top Mark:m. Height of mark:m. above G.L. /m. below G.L. Diameter of Vanes:m. Height of Cairn:m. Original Beacon has/has not been destroyed by me.	Date 7-3-79 Record of Station <i>Reconnaissance of Trig during field completion of Santangara</i> <i>Access taken off the Santangara 1:25,000 Provisional</i>	

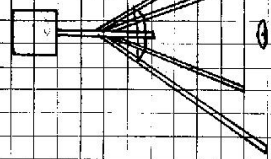

Wooden squarish with corrugated square Vane