

Department of Lands Integral Survey of N.S.W.

**RECONNAISSANCE and MAINTENANCE REPORT**

STATION TS 3604 OBSERVATORY

Co: CUMBERLAND Ph: ST PHILLIP

Map Sheet: SYDNEY 1:2000 No: U1845-11

Inspected by: R. LANDER Date: 3-12-82

Authority: SURVEY CONTROL BRANFIELD Book: 527-15 Date: 22-8-83

Beacon Diagram Not to Scale

This Trig. Station has been:-

Note: Cross out word or words which do not apply

1. Completely cleared to permit 360° vision to surrounding Trigs. ✓
2. Cleared by limes bearing..... from Trig. Mast
3. Trig. Mast & Vanes have been painted white & black respectively.
4. The Trig. was unpiled/ret-impiled, dimensions now being:
 

Description of mark..... should be explicit, e.g. Steel plug, Brass plug, Bolt, Concrete Pillar

Height of mark..... m above rock/concrete ..... m above G.L.

Height of Top Vanes to Top Mark/Top pillar plate..... m Diameter of Vanes (vertical)..... m.

Height of Cairn..... m. Diameter of Cairn..... m.

Length of Mast..... m. (approximate if not unplied)
5. A..... set in conc/rock has been placed/fd ..... m. bearing .....°M from Trig. Mast/pillar
6. A..... set in conc/soil has been placed/fd ..... m. bearing .....°M from Trig. Mast/pillar
7. A..... set in conc/soil has been placed/fd ..... m. bearing .....°M from Trig. Mast/pillar
8. A..... set in conc/rock has been placed/fd ..... m. bearing .....°M from Trig. Mast/pillar
9. Connection..... to..... m. bearing.....°M
10. Connection..... to..... m. bearing.....°M
11. Connection..... to..... m. bearing.....°M
12. Connection..... to..... m. bearing.....°M
13. Diff. Ht. .... is..... m. above below
14. Diff. Ht. .... is..... m. above below
15. Diff. Ht. .... is..... m. above below
16. Diff. Ht. .... is..... m. above below

Prepared by: D. VINCENT Checked: H. S. HERSHAM

*See above for before & after measurements*

Date	Record of Station
2-12-82	Recess marks placed & connected
22-8-83	Prior to re-impiling mark. Recess marks reconnected after mark replaced.

STATION TS 3604 OBSERVATORY

Current Occupant.....


Owners Name STATE GOVERNMENT

Address.....

Address SYDNEY OBSERVATORY

MILLERS POINT

Access As per previous report 3-12-1982  
 UBD MAP 1 FS 21-8-1983

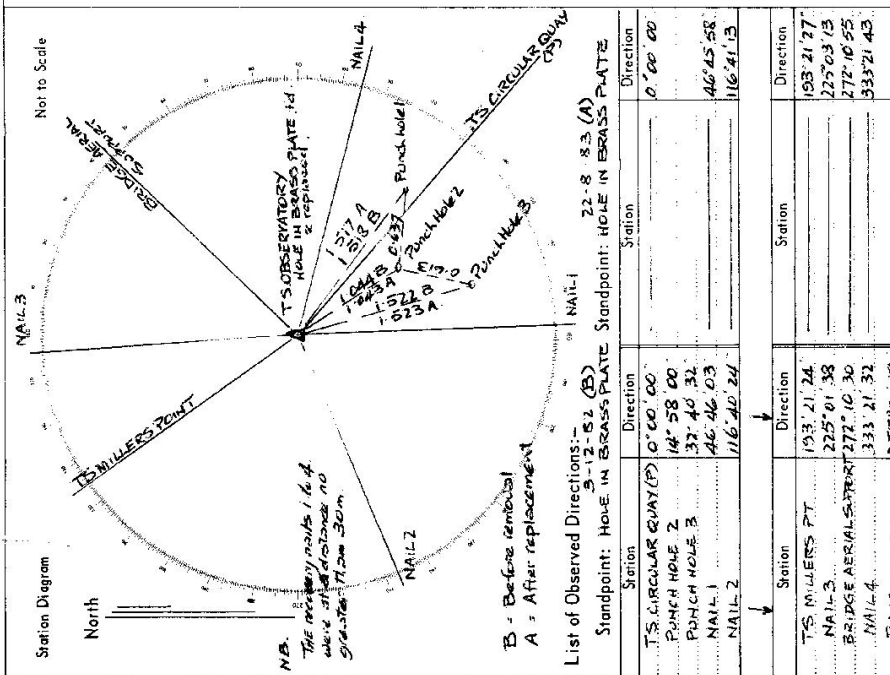

D. West, Government Printer, New South Wales - 1976